

**MIDLOTHIAN INDEPENDENT SCHOOL DISTRICT  
BAXTER ES KITCHEN RENOVATIONS**

**ADDENDUM NO. 2  
May 6, 2022**

The following items modify the Plans, and shall become a part of the Contract Documents:

**DRAWINGS:**

**ITEM NO. 01    E100 – FLOOR PLAN – LEVEL 1 - ELECTRICAL**

- A.    Added power for new kitchen serving lines.
- B.    Revised power for new double oven.
- C.    Added additional key notes under ‘NOTES BY SYMBOL’.

**ITEM NO. 02    E700 – LIGHT FIXTURE & PANEL SCHEDULES**

- A.    Revised panel schedules ‘K’ & ‘P4’.

**ITEM NO. 03    P000 – PLUMBING SPECIFICATIONS, LEGENDS, & NOTES**

- A.    Changed Note 3 under the General notes for Div. 22 Plumbing specs
- B.    Removed Note C under Tests and Inspections
- C.    Removed Note 7 under the General Plumbing Notes

**ITEM NO. 04    P100 – FLOOR PLAN – LEVEL 1 – PLUMBING**

- A.    Added the drain lines for the 3 compart sink on View 1
- B.    Added note 5 to 4 different pipes in View 1
- C.    Created note 6 in the note by symbol
- D.    Added note 6 on View 2
- E.    Added the pipe size on View 2
- F.    Added a Connect to Existing symbol on View 2

End Addendum No. 2

# T E BAXTER ELEMENTARY SCHOOL KITCHEN RENOVATION

orcutt | winslow

5016 centennial blvd

third floor

nashville, tn 37209

mail@owp.com

615.298.2525 t

www.owp.com

05/06/2022

REGISTERED ARCHITECT

BRITAIN COLUMBIA

19569

STATE OF TEXAS

© 2022 This hard copy or electronic drawing is an instrument of service and the property of Orcutt | Winslow and shall remain their property. The design professional shall not be responsible for any alterations, modifications or additions made to this drawing by any party other than the design professional. Use of this drawing shall be limited to the original and for which it was prepared and no portion thereof is expressly limited to such use, re-use or reproduction. Unless otherwise agreed in writing, design professional shall not be liable for other property interests in this drawing, and it may not be re-used for any other purpose without the design professional's written consent. Publication in any medium without or apart is prohibited without the written permission of the design professional. Any information obtained or conclusions derived from this drawing shall be at the user's sole risk.

## CONSULTANT INFO

**MEP - RWB CONSULTING ENGINEERS**  
12001 N. Central Expressway, Suite 1100  
DALLAS, TX 75243  
Nathan Hart  
nhart@rwb.net  
Office: (972) 788-4222  
Fax: (972) 788-0002

## VICINITY MAP

## SHEET INDEX

### general

SHEET #	DESCRIPTION	ORIG. ISSUE	REV. DELTA #	REV. DATE
G-001	TITLE SHEET	04/28/2022	1	05/06/2022
G-002	WALL TYPES/PROJECT INFORMATION	04/28/2022		

### architectural

SHEET #	DESCRIPTION	ORIG. ISSUE	REV. DELTA #	REV. DATE
AD101	DEMOLITION PLANS	04/28/2022		
A-101	FIRST FLOOR PLAN	04/28/2022		
A-103	FIRST FLOOR RCP	04/28/2022		
A-601	DOOR SCHED./ELEV.	04/28/2022		
A-701	FLOOR FINISH PLAN	04/28/2022		
A-702	SPECIFICATIONS	04/28/2022		

### mechanical

SHEET #	DESCRIPTION	ORIG. ISSUE	REV. DELTA #	REV. DATE
M001	SPECIFICATIONS - MECHANICAL	04/28/2022		
M100	FLOOR PLAN - LEVEL 1 - KITCHEN - HVAC	04/28/2022		

### plumbing

SHEET #	DESCRIPTION	ORIG. ISSUE	REV. DELTA #	REV. DATE
P000	PLUMBING SPECIFICATIONS, LEGENDS & NOTES	04/28/2022	1	05/06/2022
P100	FLOOR PLAN - LEVEL 1 - PLUMBING	04/28/2022	1	05/06/2022

### electrical

SHEET #	DESCRIPTION	ORIG. ISSUE	REV. DELTA #	REV. DATE
E000	ELECTRICAL NOTES & LEGENDS	04/28/2022	1	05/06/2022
E001	SPECIFICATIONS ELECTRICAL	04/28/2022		
E100	FLOOR PLAN - LEVEL 1 - ELECTRICAL	04/28/2022		
E200	FLOOR PLAN - LEVEL 1 - LIGHTING	04/28/2022		
E600	ELECTRICAL DETAILS	04/28/2022	1	05/06/2022
E700	LIGHT FIXTURE & PANEL SCHEDULES	04/28/2022		

## T E BAXTER ELEMENTARY SCHOOL KITCHEN RENOVATION 1050 PARK PLACE BLVD. MIDLOTHIAN, TX 76065

**CLIENT CONTACT**  
Midlothian ISD  
100 Walter Stephenson Rd.  
Midlothian, TX 76065

468-856-5000 T rola.fadel@msisd.gs

000-000-0001 F

**OWP PROJECT NO. DATE OF ISSUE**  
2022-110-00 04.28.2022

DELTA	DESCRIPTION	DATE
1	ADDENDUM #2	05/06/2022

**PROJECT TEAM**  
ED TEXAS TEAM

**PROJECT PHASE**  
CONSTRUCTION DOCUMENTS

**SHEET CONTENTS**  
TITLE SHEET

**SHEET NO.**

G-001

5/6/2022 2:31:38 PM orcutt | winslow / 2022-110-00 / KITCHEN RENOVATION - T E BAXTER ELEMENTARY SCHOOL / SCHEMATIC DESIGN / G-001- TITLE SHEET / TEAM  
C:\Users\lavina.e\Documents\2022\_110MBEK\_R22\_avina.e.rvt



DIVISION 22 PLUMBING SPECIFICATIONS

A. GENERAL

- THESE DRAWINGS AND ACCOMPANYING SPECIFICATIONS ARE INTENDED TO DESCRIBE AND ILLUSTRATE SYSTEMS THAT WILL NOT INTERFERE WITH THE ARCHITECTURAL AND STRUCTURAL CONDITIONS OF THE BUILDING, AND WILL FIT INTO AVAILABLE SPACES.
- CAREFULLY LAY OUT ALL WORK TO CONFORM TO THE ARCHITECTURAL, STRUCTURAL, AND FINISH CONDITIONS, AND WITH OTHER TRADES PRIOR TO STARTING ANY WORK, TO AVOID OBSTRUCTIONS AND TO ALLOW THE PROPER INSTALLATION OF EACH ITEM. CONTRACTOR SHALL BECOME FAMILIAR WITH WALL AND PARTITION LOCATIONS, CEILING HEIGHTS, FINISHES, AND OTHER PERTINENT DATA FROM ARCHITECTURAL DRAWINGS. CONTRACTOR SHALL FURTHER BECOME FAMILIAR WITH LOCATIONS OF PIERS, BEAMS, COLUMNS, JOISTS, AND OTHER PERTINENT DATA FROM STRUCTURAL DRAWINGS.
- CONTRACTOR SHALL SECURE AND PAY FOR ALL PERMITS AND INSPECTIONS. CONTRACTOR SHALL GIVE ALL NOTICES, FILE ALL NECESSARY DRAWINGS, AND OBTAIN ALL PERMITS AND CERTIFICATES FOR APPROVAL FROM THE LOCAL AUTHORITIES HAVING JURISDICTION AS REQUIRED FOR THE PARTICULAR CLASS OF WORK INVOLVED.
- EXECUTE ALL WORK IN ACCORDANCE WITH (BASE BUILDING STANDARDS SET FORTH BY THE BUILDING OWNER) AND LOCAL, STATE, NATIONAL, CODES, ORDINANCES, AND OTHER APPLICABLE REGULATIONS GOVERNING THE PARTICULAR CLASS OF WORK INVOLVED. THE GOVERNING CODES ARE MINIMUM REQUIREMENTS AND WHERE THE CONTRACT DOCUMENTS EXCEED CODE REQUIREMENTS, THESE DOCUMENTS SHALL PREVAIL.
- UNLESS SPECIFICALLY DIRECTED OTHERWISE, FURNISH AND INSTALL EACH AND EVERY ITEM CONTAINED IN, AND ASSOCIATED WITH, THE PARTICULAR CLASS OF WORK INVOLVED AS SHOWN ON THE DRAWINGS AND FURTHER DESCRIBED IN THESE SPECIFICATIONS, TOGETHER WITH ALL APPURTENANCES AND INCIDENTALS NECESSARY TO COMPLETE THE WORK. THIS SHALL INCLUDE, BUT NOT NECESSARILY BE LIMITED TO, LABOR, TRANSPORTATION, TOOLS, STORAGE, CUTTING, PATCHING AND CLEAN-UP.
- LOCATE ALL EQUIPMENT, FIXTURES, DUCTWORK, PIPING, AND OTHER ITEMS IN APPROXIMATE LOCATIONS SHOWN. PROVIDE ANY ADDITIONAL SUPPORTS, HANGERS, AND OPENINGS, AS REQUIRED FOR A COMPLETE AND SATISFACTORILY OPERATING INSTALLATION. COORDINATE ALL WORK TO PROVIDE FOR ALL SERVICE AND ACCESS CLEARANCES AS RECOMMENDED BY THE EQUIPMENT MANUFACTURER. ALL EQUIPMENT AND INSTALLATIONS SHALL BE INSTALLED PER MANUFACTURER'S RECOMMENDATIONS.
- THE LOCATIONS, POINTS OF CONNECTION, DIMENSIONAL DATA AND OTHER MEASUREMENTS SHOWN ARE OFFERED AS A GENERAL GUIDE ONLY AND WITHOUT GUARANTEE OF COMPLETE ACCURACY. ALL EXISTING ITEMS SHOWN ARE NOT TAKEN FROM EXISTING "AS-BUILT" DRAWINGS AT LIMITED FIELD SURVEY. CONTRACTOR SHALL VISIT THE SITE, AND REASONABLY FIELD VERIFY THE WORKING CONDITIONS REQUIRED TO INSTALL THE PARTICULAR CLASS OF WORK INVOLVED. MAKE PROVISIONS IN BID FOR SAME TO ASSURE THAT THE RESULTING INSTALLATION WILL BE COMPLETE, COORDINATED, AND RESULT IN A PROPERLY OPERATING SYSTEM.
- CONTRACTOR SHALL PROVIDE THE OWNER WITH ONE COPY OF THESE DRAWINGS, MARKED WITH ANY ADDITIONS TO, OR DEVIATIONS FROM, THE WORK ILLUSTRATED, TO REPRESENT "AS-BUILT" CONDITIONS.
- CONTRACTOR SHALL GUARANTEE THE ENTIRE INSTALLATION AGAINST DEFECTS IN MATERIALS AND WORKMANSHIP FOR A PERIOD OF ONE (1) YEAR AFTER SUBSTANTIAL COMPLETION.
- COOPERATE WITH OTHER TRADES TO KEEP THE WORK AREA CLEAN AND FREE OF UNNECESSARY MATERIALS OR DEBRIS ON A DAILY BASIS. WHEN WORK IS COMPLETE, REMOVE ALL TOOLS, SCAFFOLDING, MACHINERY, AND DEBRIS. CLEAN ALL DIRT AND DUST FROM ITEMS OF WORK AND BROOM SWEEP THE WORK AREA DAILY.
- COOPERATE WITH THE OWNER'S REPRESENTATIVE AND OTHER TRADES TO MEET THE ESTABLISHED CONSTRUCTION SCHEDULE. SCHEDULE WORK SO AS TO AVOID DELAYING OTHER TRADES.
- PROVIDE PIPING MARKERS FOR THE PIPING SYSTEMS, TO INCLUDE FLOW ARROWS, EVERY 30' ON CENTER AND 3'-0" BEFORE AND AFTER ELBOWS OR TEES.
- SUBMIT ON ALL EQUIPMENT AND MATERIALS SPECIFIED HEREIN PRIOR TO COMMENCING WITH ANY WORK. FAILURE TO COMPLY WILL RESULT IN REPLACEMENT OF ALL ITEMS FOUND NOT IN COMPLIANCE WITH THESE REQUIREMENTS.
- PROTECT ALL BUILDING COMPONENTS, WALLS, ROOFS, FLOORS, ADJACENT EQUIPMENT, LIGHTING, ETC. ANY ITEMS DAMAGED, OR WHERE FINISHES HAVE BEEN MARRED, SHALL BE REPAIRED TO THEIR ORIGINAL CONDITION AT NO COST TO THE OWNER. ALL ITEMS SOILED IN THE PROGRESS OF WORK SHALL BE CLEANED TO A "LIKE NEW," OR PRE-EXISTING, CONDITION.
- AT TIME OF FINAL INSTALLATION OBSERVATIONS, THE OPERATION OF ALL SYSTEMS OF EQUIPMENT SHALL HAVE BEEN DEMONSTRATED TO PERFORM PROPERLY.
- ANY DISCREPANCIES DISCOVERED BY THE CONTRACTOR DURING BIDDING SHALL BE BROUGHT TO THE ATTENTION OF THE ARCHITECT OR ENGINEER SO THAT AN ADDENDUM MAY BE ISSUED TO ADDRESS THOSE ITEMS PRIOR TO BIDDING. ANY DISCREPANCIES DISCOVERED AFTER BIDDING, THAT WERE REASONABLE TO HAVE BEEN DISCOVERED, SHALL BE CORRECTED AT THE EXPENSE OF THE CONTRACTOR.
- FOR RENOVATION AND REMODEL WORK, CAREFULLY REMOVE AND PROTECT ALL UNUSED EXISTING FIXTURES/EQUIPMENT, PIPING, DUCTWORK, ELECTRICAL SERVICES, AND ALL OTHER ITEMS ASSOCIATED THEREWITH WHERE INDICATED. COORDINATE WITH OWNERS REPRESENTATIVE PRIOR TO REMOVAL AND DISPOSAL. TO VERIFY WHETHER OWNER DESIRES TO KEEP ANY EXISTING ITEMS AND THE DESIRED MANNER OF DISPOSITION THEREOF. STORE ALL REMOVED ITEMS ON SITE FOR A MINIMUM OF TWO (2) WEEKS, UNLESS INDICATED OTHERWISE BY THE OWNER'S REPRESENTATIVE. TO ALLOW FOR INSPECTION BY THE OWNER. ALL ITEMS NOT RETAINED BY THE OWNER SHALL BE REMOVED FROM THE SITE BY THE CONTRACTOR AT THE CONTRACTOR'S EXPENSE. REFER TO ARCHITECTURAL, MECHANICAL, AND ELECTRICAL DEMOLITION DRAWINGS.
- EXISTING BUILDING OPERATIONS MUST REMAIN ACTIVATED AT ALL TIMES DURING NORMAL OPERATING HOURS. OBTAIN PERMISSION FROM OWNERS REPRESENTATIVE PRIOR TO SHUTTING-DOWN ANY BUILDING SYSTEM. PROVIDE TEMPORARY CONNECTIONS OF UTILITIES AND AIR CONDITIONING AS NECESSARY TO FACILITATE THE PHASES OF CONSTRUCTION. MAINTAIN AIR DISTRIBUTION AND PIPING SYSTEMS TO OTHER FLOORS OF THE BUILDING OUTSIDE OF THE DEMOLITION AREA. SHUT DOWN OF EXISTING SYSTEMS SHALL OCCUR DURING UNOCCUPIED PERIODS WHERE POSSIBLE.
- PENETRATIONS OF THE CEILINGS, WALLS, OR FLOORS SHALL BE PATCHED, SLEEVED, SEALED, ESCUTCHEONED, AND RESTORED TO THE ORIGINAL FINISH CONDITIONS AND FIRE RATINGS. COORDINATE ALL PENETRATIONS WITH OTHER TRADES.

B. PLUMBING SCOPE OF WORK:

- PROVIDE ALL MATERIALS, EQUIPMENT, AND PAY ALL COSTS CONNECTED WITH THE MODIFICATIONS OF EXISTING PLUMBING SYSTEMS AS SHOWN ON THE DRAWINGS, AND AS HEREINAFTER SPECIFIED.
- IT SHALL BE THE CONTRACTOR'S RESPONSIBILITY TO FURNISH ALL ITEMS OF MATERIAL AND LABOR, AND ALL OTHER COSTS, TO COMPLETE THE WORK WITHIN THE INTENT OF THESE DRAWINGS, EVEN THOUGH EACH AND EVERY ITEM NECESSARY IS NOT SPECIFICALLY MENTIONED OR SHOWN.
- SUBMIT MANUFACTURER'S BROCHURES ON BASIC MATERIALS AND PLUMBING FIXTURES TO THE ARCHITECT AND ENGINEER FOR REVIEW AND APPROVAL.
- ALL WORK SHALL BE AS INDICATED ON THE DRAWINGS AND SHALL INCLUDE, BUT NOT BE LIMITED TO:
  - DOMESTIC COLD WATER SYSTEM, INCLUDING DISTRIBUTION AND BACKFLOW PREVENTION, AS REQUIRED BY CODE AND CONNECTION TO EXISTING WATER SUPPLIES.
  - DOMESTIC HOT WATER SYSTEM, INCLUDING EXTENDING AND CONNECTION TO DISTRIBUTION PIPING.
  - TRIM FOR PLUMBING FIXTURES, INCLUDING SETTING, AND FINAL CONNECTIONS.
  - THERMAL INSULATION OF ALL PIPING SYSTEMS.
  - ROUGH-IN AND FINAL CONNECTIONS FOR OWNER FURNISHED EQUIPMENT AND EQUIPMENT FURNISHED BY OTHER TRADES.
  - ALL PERMITS AND FEES.
  - INSPECTION AND TESTING.

C. PLUMBING MATERIALS AND WORKMANSHIP:

1. UTILITY CONNECTIONS:

- CONTRACTOR SHALL, BEFORE COMMENCEMENT OF THE PROJECT, VERIFY THE LOCATION, DEPTH, SIZE, AND PRESSURE OR GRADE OF ALL EXISTING BUILDING UTILITY LINES TO WHICH CONNECTIONS FOR SERVICE ARE TO BE MADE. IF, FOR ANY REASON, CONDITIONS APPEAR TO BE UNUSUAL, THE CONTRACTOR SHALL ADVISE THE ARCHITECT AND OPERATION OF THESE SYSTEMS, SUCH CONDITIONS SHALL BE REPORTED TO THE PROJECT COORDINATOR IN WRITING FOR RESOLUTION THEREBY.

2. SANITARY SEWER/VENT SYSTEM:

- FURNISH AND INSTALL A COMPLETE SANITARY SYSTEM OF SOIL, WASTE, AND VENT PIPING FOR ALL NEW AND RELOCATED FIXTURES, DRAINS, EQUIPMENT DISCHARGES, ETC., AS SHOWN ON THE DRAWINGS AND HEREINAFTER SPECIFIED. ALL PIPING SHALL RUN STRAIGHT AS POSSIBLE AND BE INSTALLED TO GRADE A MINIMUM OF 1/4" PER FOOT FOR PIPING 3" AND SMALLER, AND 1/8" PER FOOT FOR PIPING 4" AND LARGER, UNLESS NOTED OTHERWISE. INSTALL THE SYSTEM IN ACCORDANCE WITH ALL LOCAL CODES.
- SANITARY SYSTEM WASTE AND VENT PIPING SHALL BE CISPI 301, OR ASTM B898 SERVICE WEIGHT ASPHALTUM COATED CAST IRON SOIL PIPE AND ASTM A74 WEIGHT CAST IRON FITTINGS. JOINTS SHALL BE MADE WITH A STAINLESS STEEL CORRUGATED SHIELD AND CLAMP ASSEMBLY OVER ONE PIECE NEOPRENE SEALING SLEEVE. CLAMP-ALL "HI-TORQ 80" OR HUSKY SD-2000. CONTRACTOR SHALL INSTALL ALL UNDERGROUND SANITARY PIPING WITH POLY VINYL CHLORIDE (PVC) SCHEDULE 40, 12" ARMALFLEX OR APPROVED EQUAL. CONDENSATE DRAIN: 1/2" ARMALFLEX OR APPROVED EQUAL. COPPER TUBING BELOW SLAB OR CAST IN CONCRETE: 1/2" ARMALFLEX OR APPROVED EQUAL.
- PVC PIPE MATERIAL SHALL NOT BE ALLOWED TO SERVE FIXTURES, DRAINS, OR EQUIPMENT SUBJECT TO RECEIVING FLUIDS WITH TEMPERATURES OF 140 DEG.F. OR HIGHER. PROVIDE CAST IRON SERVICE WEIGHT "AS-BUILT" DRAWINGS AT LIMITED FIELD SURVEY. EXTEND A MINIMUM OF 20" (TWENTY FEET) TO MAIN WASTE LINE TO ASSURE HIGH TEMPERATURE COOLING IN CAST IRON PIPE BEFORE ENTERING PVC PIPING MATERIAL. WHERE PVC IS NOT TO BE USED BELOW GRADE PROVIDE CAST IRON PIPE WITH BELL AND SPIGOT JOINTS, AND USE NEOPRENE COMPRESSION GASKET SEALS, ASTM C564. PIPES AND JOINTS SHALL BE MARKED WITH THE APPLICABLE CISPI STANDARD COMPLIANCE COLLECTIVE TRADEMARK.

3. FLOOR DRAINS/FLOOR SINKS:

- CURRENTLY THERE ARE NO NEW FLOOR DRAINS OR FLOOR SINKS. ALL NEW FIXTURES AND EQUIPMENT WILL DISCHARGE OPEN SITE AT EXISTING FLOOR DRAINS AND FLOOR SINKS.

4. FIELD QUALITY CONTROL

- FURNISH INSTRUMENTS, EQUIPMENT, AND LABOR NECESSARY TO CONDUCT TESTS.
- TEST DRAINAGE, WASTE, AND VENTING PIPING WITH WATER BEFORE FIXTURES ARE INSTALLED.
- AFTER PLUMBING FIXTURES HAVE BEEN SET AND TRAPS FILLED WITH WATER, SUBMIT ENTIRE DRAINAGE, WASTE, AND VENTING SYSTEM TO FINAL TEST WITH SMOKE.

5. DOMESTIC WATER SYSTEM:

- FURNISH AND INSTALL A COMPLETE WATER SUPPLY SYSTEM WITH BRANCH LINES SERVING ALL NEW AND RELOCATED PLUMBING AND FIXTURES, FAUCETS, EQUIPMENT, ETC., AS INDICATED ON THE DRAWINGS, AND AS SPECIFIED HEREIN.
- PIPE MATERIALS: WATER PIPING LOCATED ABOVE GRADE 2-1/2" AND SMALLER SHALL BE, ASTM E88 TYPE "L" HARD COPPER TUBING WITH ANSI B16.22 WROUGHT COPPER FITTINGS. JOINTS SHALL BE MADE WITH 95% SOLDER. WATER PIPING LOCATED BELOW GRADE SHALL BE, ASTM B88 TYPE "K", SOFT COPPER. THERE SHALL BE NO JOINTS IN TUBING LOCATED UNDER THE SLAB.
- VALVES: PROVIDE BRONZE LEAD FREE BALL VALVES WITH STAINLESS STEEL BALL AND STEMS FOR PIPE SIZES 2 1/2" AND SMALLER. VALVES SHALL BE EQUAL TO THAT AS MANUFACTURED BY HAMMOND - ULTRAPURE.
- RO WATER PIPING: ALL REVERSE OSMOSIS PIPING SHALL BE SCH. 40 SOCKET FUSED, UNCOMPRESSED TYPE 2 VIRGIN POLYPROPYLENE CONFORMING TO ASTM D4101. FITTINGS SHALL BE BY SAME MANUFACTURER AS THE PIPING AND SHALL BE SOCKET FUSION UNIMPREGNATED TYPE 2 VIRGIN COPOLYMER POLYPROPYLENE. BALL VALVES SHALL BE DOUBLE-BLOCKING TYPE WITH O-RING CUSHIONS UNDER THE PTFE SEATS, VIRGIN, UNIMPREGNATED TYPE 1 HOMOPOLYMER POLYPROPYLENE. ACCEPTABLE MANUFACTURER: IPEX - ENPURE HIGH-PURITY POLYPROPYLENE OR EQUAL BY ORION.
- PIPING SHALL BE INSTALLED WITH A GRADE FOR DRAINAGE TOWARD MAIN SUPPLY RISERS AND TO FIXTURE CONNECTIONS TO ALLOW COMPLETE DRAINAGE OF THE SYSTEM.
- WATER SYSTEM SHALL BE STERILIZED WITH A SOLUTION OF HTH IN ACCORDANCE WITH THE REQUIREMENTS OF THE STATE PUBLIC HEALTH DEPARTMENT. PUMP THE HTH SOLUTION INTO THE WATER SYSTEM AND FILL THE COMPLETE SYSTEM, INCLUDING BRANCH PIPES. EACH OUTLET SHALL BE PURGED FOR AIR DURING THE STERILIZATION PROCESS. SYSTEM SHALL BE COMPLETELY FLUSHED AFTER STERILIZATION.
- AT EACH FIXTURE FAUCET, PROVIDE A STOP VALVE IN EACH SUPPLY. STOP VALVES SHALL BE IN ACCORDANCE WITH PLUMBING CODE. PROVIDE IN-LINE CHECKS ON WATER SUPPLIES AT FAUCET WHERE REQUIRED TO PREVENT CROSS-CONNECTIONS. INSTALL AIR CHAMBERS 1'-6" MINIMUM HEIGHT AT ALL CONNECTIONS AND ASSE 1010 APPROVED & PDI CERTIFIED SHOCK ARRESTERS EQUAL TO "HYDRA-RESTER", SIOUX CHIEF MANUFACTURING CO.
- VACUUM BREAKERS:
  - ACCEPTABLE MANUFACTURER:
    - WATTS.
    - FEBCO.
    - BECCO.
  - ATMOSPHERIC CHECK VALVE TYPE.
  - BRONZE BODY CONSTRUCTION WITH POLISHED CHROME FINISH.
- SPILL-RESISTANT VACUUM BREAKERS:
  - ACCEPTABLE MANUFACTURER:
    - WATTS.
    - FEBCO.
    - BECCO.
  - ANTI-SIPHON
  - TESTABLE, CHECK VALVE TYPE.
  - LEAD FREE BRONZE BODY CONSTRUCTION WITH POLISHED CHROME FINISH.
  - EQUAL TO WATTS LF08PCQT
- REDUCED PRESSURE TYPE BACKFLOW PREVENTER ASSEMBLY (FOR NON-RO WATER).
  - ACCEPTABLE MANUFACTURERS:
    - WATTS.
    - BECCO.
    - AMES.
  - DOUBLE CHECK VALVE TYPE WITH SHUTOFF VALVES
    - QUARTER TURN BALL SHUT-OFF VALVES UP TO 2-1/2 INCHES.
    - OUTSIDE STEM AND YOKE GATE SHUT-OFF VALVES 3 INCHES AND OVER.
  - DIFFERENTIAL PRESSURE TYPE RELIEF VALVE WITH AIR GAP FITTING.
  - LEAD-FREE BRONZE BODY CONSTRUCTION UP TO 2-1/2 INCHES.
  - CAST IRON BODY CONSTRUCTION 3 INCHES AND OVER.
  - PROVIDE IN-LINE UPSTREAM Y-TYPE STRAINER.
    - 20 MESH STRAINER 2 INCHES AND BELOW.
    - 0.125 PERFORATED SCREEN MESH 2-1/2 INCHES AND OVER.
  - ACCEPTABLE PRODUCT: WATTS NO. 909S (FDA)-QT.
- REDUCED PRESSURE TYPE BACKFLOW PREVENTER ASSEMBLY - STAINLESS STEEL (FOR CONNECTION TO COMMERCIAL DISHWASHERS):
  - ACCEPTABLE MANUFACTURERS:
    - WATTS.


- APOLLO.
- WILKINS.
- DOUBLE CHECK VALVE TYPE WITH SHUTOFF VALVES.
- QUARTER TURN BALL SHUT-OFF VALVES UP TO 1 INCHES.
- DIFFERENTIAL PRESSURE TYPE RELIEF VALVE WITH AIR GAP FITTING.
- LEAD-FREE STAINLESS STEEL BODY CONSTRUCTION UP TO 1 INCHES.
- PROVIDE IN-LINE UPSTREAM Y-TYPE STRAINER.
  - 20 MESH STRAINER 1 INCHES AND BELOW.
  - ACCEPTABLE PRODUCT: WATTS NO. 009SS-QT.

- PROVIDE STAINLESS STEEL, 16 INCH BY 16 INCH ACCESS DOORS WITH CAM LOCKS EQUAL TO MILCOR STYLE "K, M OR DW" AS REQUIRED FOR ACCESS TO ALL VALVES BEHIND GYPSUM BOARD CEILINGS AND WALLS, PAINT TO MATCH ADJACENT FINISHES.
- INSTALL BRONZE LEAD FREE CHECK VALVES IN THE HOT AND COLD WATER BRANCHES TO MIXING TYPE FAUCETS OR MIXING VALVES, AS REQUIRED TO PREVENT CROSS-CONNECTIONS.

- INSULATION: INSULATION OF ALL DOMESTIC HOT AND COLD WATER PIPING WITHIN THE BUILDING AND ALL CONDENSATE DRAIN PIPING.
  - DOMESTIC COLD AND HOT WATER: ONE INCH (1") THICK, 4 POUND OR HEAVIER DENSITY, MOLDED SECTIONAL GLASS FIBER PIPE COVERING WITH FACTORY APPLIED, WHITE FRG, FIRE RESISTANT, VAPOR BARRIER JACKET. USE 7 PBF DENSITY INSULATION INSERTS WITH 16 GAUGE MOLDED FIBERGLASS WITH FIRE RESISTANT JACKET. ELBOWS AND FITTINGS WILL BE THE SAME THICKNESS.
  - CONDENSATE DRAIN: 1/2" ARMALFLEX OR APPROVED EQUAL.
  - COPPER TUBING BELOW SLAB OR CAST IN CONCRETE: 1/2" ARMALFLEX OR APPROVED EQUAL.

6. TESTS AND INSPECTIONS

- WASTE AND VENT PIPING SHALL BE TESTED ON COMPLETION OF THE ROUGH WORK AND BEFORE FIXTURES AND TRAPS ARE CONNECTED. ALL OPENINGS, EXCEPT HIGHEST VENTS, ARE TO BE PLUGGED AND THE SYSTEM COMPLETELY FILLED WITH WATER. SYSTEM SHALL STAND WITHOUT LEAK OR LOSS OF WATER FOR A PERIOD OF NOT LESS THAN FOUR (4) HOURS.
- ALL WATER PIPING SHALL BE PRESSURIZED HYDRAULICALLY AT 150 POUNDS PER SQUARE INCH AND THIS PRESSURE SHALL BE HELD WITHOUT ADDITIONAL PRESSURIZATION FOR NOT LESS THAN ONE (1) HOUR. EQUIPMENT, ETC., IN THE SYSTEM THAT MAY BE DAMAGED BY THIS PRESSURE SHALL BE ISOLATED OR DISCONNECTED FROM THE SYSTEM.

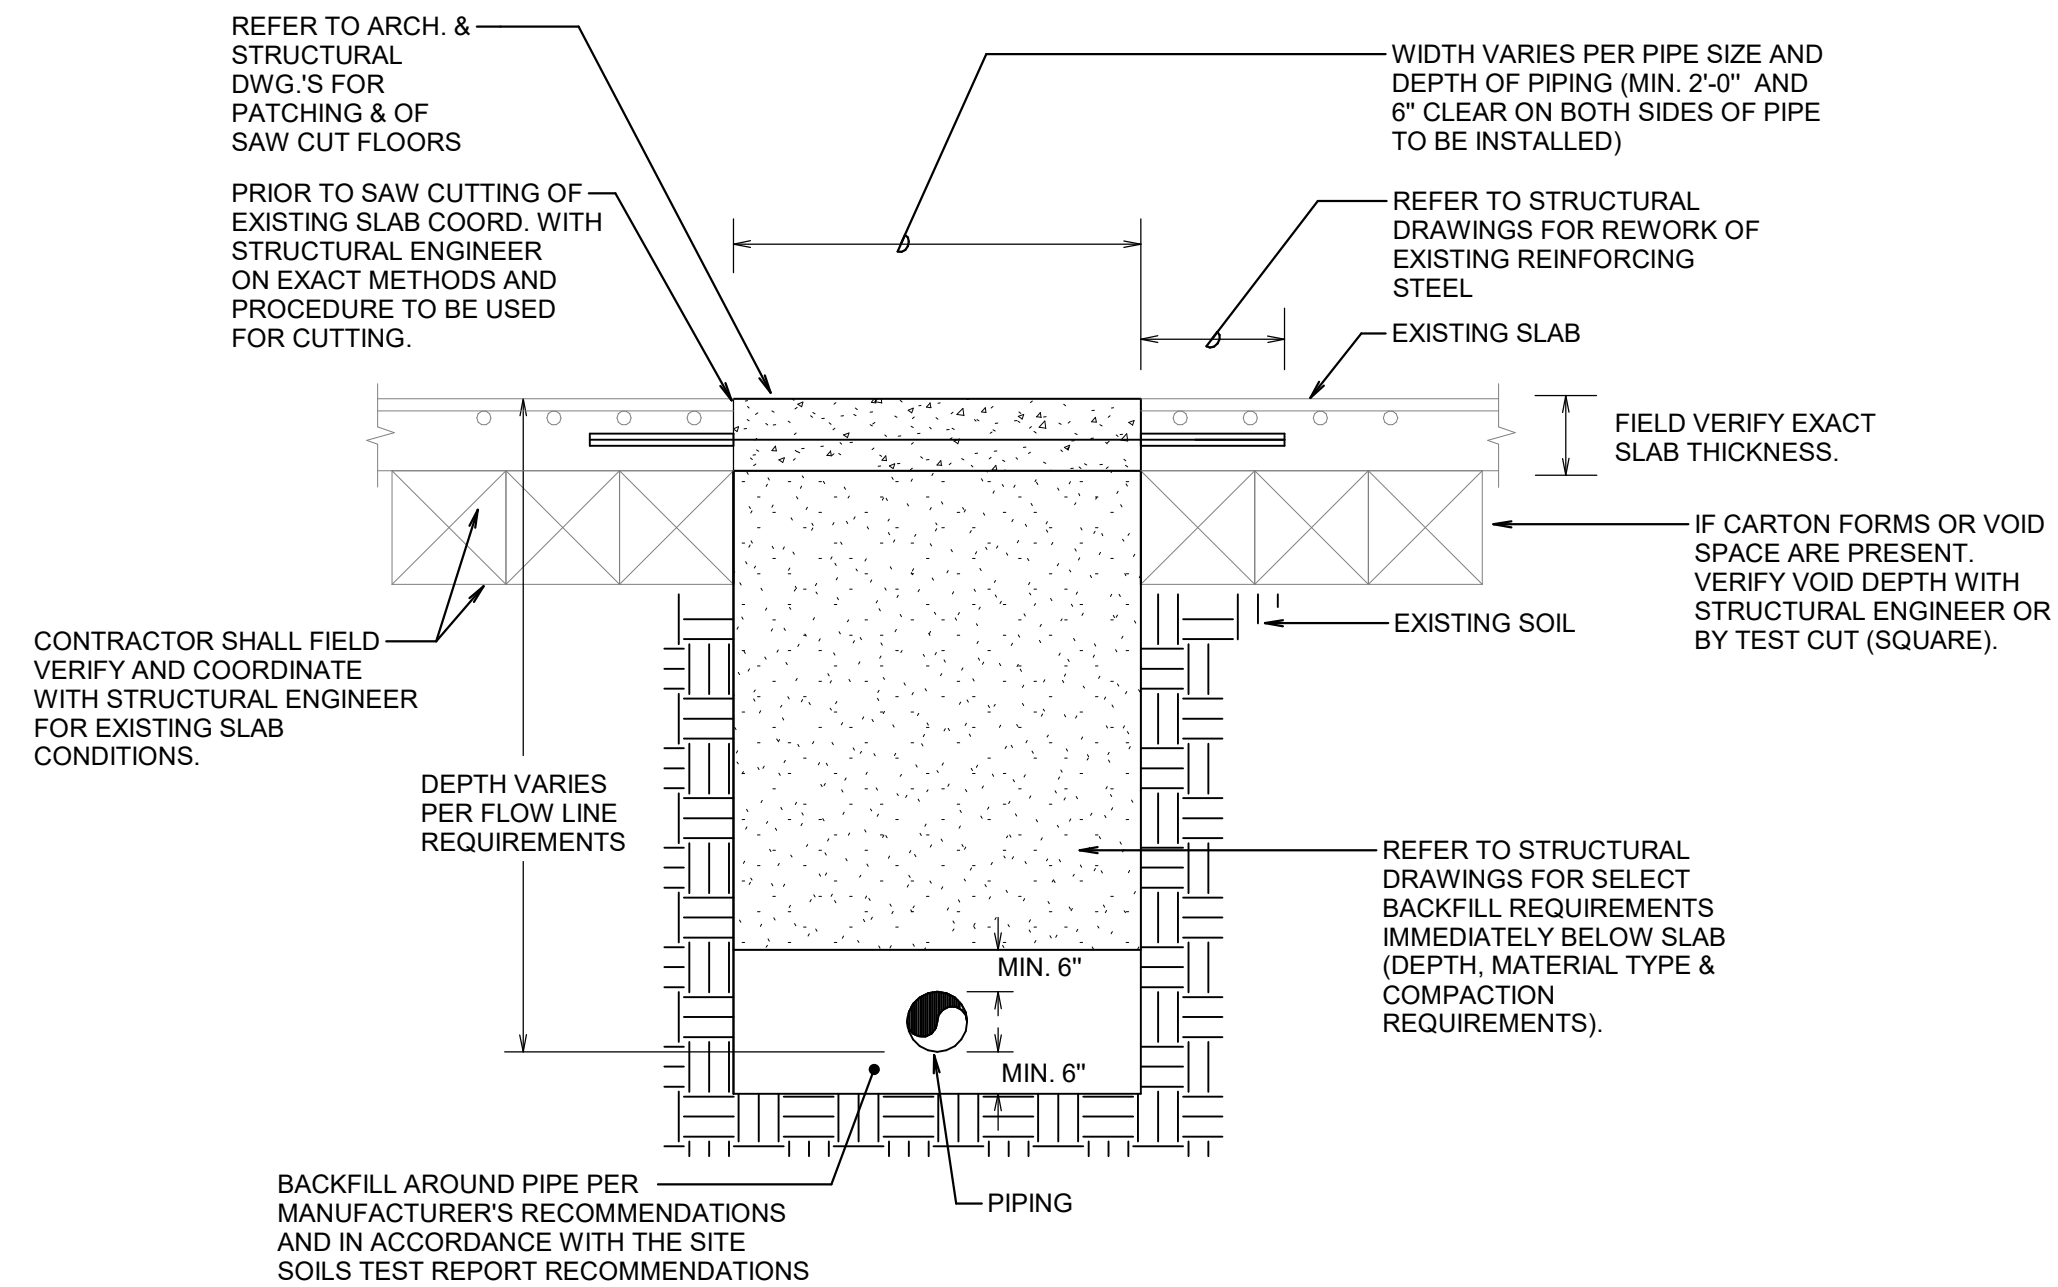

NOTE: INFORMATION PROVIDED IS NOT INTENDED TO REFLECT THE EXACT SLAB TYPE BUT IS INTENDED FOR GENERAL BACKFILL INFORMATION ONLY. CONTRACTOR SHALL FIELD VERIFY EXISTING SLAB TYPE, THICKNESS, REINFORCING, AND COORDINATE SAW CUTTING REQUIREMENTS WITH THE STRUCTURAL ENGINEER PRIOR TO PERFORMING ANY WORK.

1 EXISTING FOUNDATION UNDERFLOOR PIPING DETAIL  
NO SCALE

REVERSE OSMOSIS SYSTEM CIRCULATION PUMP SCHEDULE

DESIGNATION	PUMP TYPE	MANUFACTURER	MODEL	SERVICE	GPM	PUMP HEAD	RPM	ELECTRICAL DATA				DESCRIPTION
CP-1	CIRCULATION PUMP	GRUNFOS	UPS26-99SCF	RO SYSTEM	33 GPM	29 FT	3150	HP	VOLTS	PH	HZ	
								0.18 hp	120 V	1	60 HZ	AT SPEED 3 - STAINLESS STEEL BODY

PLUMBING LEGEND

SYMBOL	DESCRIPTION
---	DOMESTIC COLD WATER (CW)
----	DOMESTIC HOT WATER (HW)
-----	DOMESTIC HOT WATER RETURN (HWR)
----	SANITARY WASTE (SS)
-----v-----	SANITARY VENT (V)
----	REVERSE OSMOSIS WATER (RO)
☒	FLOOR DRAIN
☒	FLOOR SINK
☒	GAS METER
☒	ROOF PIPE SUPPORT
☒	PLUG VALVE
☒	GAS PRESSURE REGULATOR
+	RISE & DROP IN PIPING
☒	CLEANOUT
+	BALL VALVE
+	CHECK VALVE
	UNION
+	GAS COCK
+	PRESSURE REDUCING VALVE
+	PRESSURE RELIEF VALVE
+	HOSE BIBB
+	NEW CONNECTION TO EXISTING
O.F.C.I.	OWNER FURNISHED CONTRACTOR INSTALLED
B.T.C.	BRANCH TO CONNECTION
A.F.F.	ABOVE FINISHED FLOOR
B.F.F.	BELOW FINISHED FLOOR
B.F.G.	BELOW FINISHED GRADE
EXT. GB.	EXTERIOR GRADE BEAM
ℓ	FLOWLINE ELEVATION
CO	CLEAN OUT
FCO	FLOOR CLEAN OUT
GCO	GRADE CLEAN OUT
DCO	DOUBLE CLEAN OUT
WCO	WALL CLEAN OUT
VTR	VENT THROUGH ROOF
(E)	EXISTING UTILITIES
D.S.	DOWNSPOUT
☒	SQUARE FEET


NOTE: NOT ALL SYMBOLS SHOWN ARE NECESSARILY USED

GENERAL PLUMBING NOTES:

- ALL DIMENSIONS AND FIELD CONDITIONS SHALL BE CHECKED AND VERIFIED BY CONTRACTOR AT THE SITE. THE LOCATION OF ALL NEW PIPING, FIXTURES, EQUIPMENT, LOCATIONS, SIZES, SCALES, AND DIMENSIONS SHALL BE CHECKED AND VERIFIED ON SITE.
- CONTRACTOR SHALL LAY OUT THEIR WORK BASED ON ACTUAL FIELD MEASUREMENTS AND ACTUAL DIMENSIONS OF EQUIPMENT AND FIXTURES INSTALLED. ALL PIPING AND EQUIPMENT OF ALL TRADES SHALL BE PROPERLY COORDINATED AND SET IN PLACE TO MAINTAIN REQUIRED SERVICE CLEARANCES. ALL INSTALLATIONS SHALL BE SUBJECT TO THE APPROVAL OF THE ARCHITECT.
- CONTRACTOR SHALL CHANGE THE LOCATION OF NEW PIPING, WHERE REQUIRED, TO MEET FIELD CONDITIONS.
- CONTRACTOR SHALL SUBMIT COMPLETE PRODUCT DATA ALONG WITH SHOP DRAWINGS. PREPARE AND SUBMIT 1/4" = 1'-0" SCALE PLUMBING PIPING SHOP DRAWINGS. CONTRACTOR SHALL FULLY COORDINATE ALL PIPING SHOP DRAWINGS WITH SHEET METAL SHOP DRAWINGS AND WITH THE WORK OF ALL OTHER TRADES. PRIOR TO SUBMITTAL SHOP DRAWINGS SHALL BE CHECKED FOR CONFLICTS AND INTERFERENCES, ETC. FAILURE TO SUBMIT SHOP DRAWINGS IN A TIMELY MANNER AS REQUIRED TO KEEP PACE WITH THE CONSTRUCTION SCHEDULE MAY RESULT IN DELAYS, AND POSSIBLE STOPPAGE OF PAYMENT TO THE CONTRACTOR. ADDITIONALLY, NO WORK MAY PROCEED UNTIL SUCH SHOP DRAWINGS ARE SUBMITTED, REVIEWED, AND FOUND TO BE ACCEPTABLE BY THE ARCHITECT AND ENGINEER.
- REFER TO AVAILABLE STRUCTURAL PLANS FOR EXACT LOCATION OF STRUCTURAL PIERS, BEAMS, JOISTS AND OTHER STRUCTURAL ELEMENTS. MODIFY PIPE ROUTING AS REQUIRED TO AVOID CONFLICTS WHERE SUCH OCCURS.
- REFER TO ARCHITECTURAL DRAWINGS FOR THE EXACT LOCATIONS OF ALL WALLS, PARTITIONS, CEILINGS, CEILING HEIGHTS, AND EQUIPMENT/FIXTURES.
- CONTRACTOR SHALL CONFIRM SCALE OF PLUMBING DRAWINGS BY COMPARISON WITH ARCHITECTURAL DRAWINGS TO VERIFY THE ACCURACY OF ALL TAKE-OFFS MADE DURING THE BIDDING PERIOD.
- ANY PIPE PENETRATIONS OF CEILINGS, WALLS OR FLOORS SHALL BE RESTORED TO THE FIRE RATINGS INDICATED ON THE ARCHITECTURAL DRAWINGS. FLOOR, WALL AND CEILING PIPING PENETRATIONS SHALL BE PATCHED, SLEEVED, SEALED, AND BE PROVIDED WITH APPROPRIATE ESCUTCHEONS WHERE LOCATED IN FINISHED/EXPOSED SPACES.
- REFER TO ARCHITECTURAL DRAWINGS FOR EXACT LOCATION OF FLOOR DRAINS, PLUMBING FIXTURES, & KITCHEN EQUIPMENT.
- ALL GREASE WASTE AND SANITARY SEWER PIPING THAT RECEIVES A DISCHARGE OF WASTE OR WATER THAT IS 140 DEGREE F. OR GREATER IN TEMPERATURE SHALL BE STANDARD WEIGHT CAST IRON PIPE WITH HUB AND SPIGOT FITTINGS FOR BURIED PIPING (UNDER DIRT EVEN IF IN A CRAWL SPACE) INSTALLATIONS AND NO HUB FOR ABOVE SLAB INSTALLATIONS OR SUSPENDED ABOVE GROUND IN A CRAWL SPACE. WITHOUT EXCEPTION, EXTEND CAST IRON PIPE TO BE A MINIMUM OF 20 TWENTY LINEAR FEET IN LENGTH BEFORE ALLOWING TRANSITION BACK TO ANOTHER PIPE MATERIAL, OR AFTER CONNECTING TO A MAIN DRAIN LINE.
- CONTRACTOR SHALL NOT DEViate FROM THE CONSTRUCTION DOCUMENTS. ANY DEVIATION SHALL RECEIVE WRITTEN ACCEPTANCE AND APPROVAL FROM THE OWNER AND ARCHITECT IN ADVANCE OF SUCH WORK BEING PERFORMED. SUBMIT SUCH REQUESTS TO THE ARCHITECT AND ENGINEER ALONG WITH THE MONETARY CREDIT, AS APPLICABLE. ANY DEVIATIONS FROM THE CONTRACT DOCUMENTS FOUND ON THE PROJECT THAT DID NOT RECEIVE A LETTER OF CERTIFICATION AND APPROVAL FROM THE ARCHITECT AND ENGINEER SHALL BE FULLY REPLACED AND SHALL BE MADE TO BE IN FULL COMPLIANCE WITH THE CONSTRUCTION DOCUMENTS AT THE EXPENSE OF THE CONTRACTOR.

GENERAL DEMOLITION NOTES:

- THE INFORMATION SHOWN ON THE DEMOLITION DRAWINGS IS NOT TAKEN FROM "AS-BUILT" DRAWINGS. CONTRACTOR SHALL BE RESPONSIBLE FOR VISITING THE SITE PRIOR TO SUBMITTING A BID TO DETERMINE THE GENERAL AMOUNT OF WORK THAT WILL BE REQUIRED. CONTRACTOR SHALL EXAMINE THE EXISTING BUILDING, VERIFY THE GENERAL LOCATION OF ALL EXISTING WORK, AND BECOME INFORMED AS TO THE RELATION TO AND IMPACT ON THE WORK REQUIRED. SUBMISSION OF A BID WILL CONSTITUTE EVIDENCE THAT THE CONTRACTOR HAS INSPECTED THE SITE IN THE FASHION NOTED ABOVE.
- COORDINATE DEMOLITION WORK WITH BUILDING MAINTENANCE PERSONNEL AND OTHER TRADES PERFORMING WORK IN THE BUILDING PRIOR TO THE REMOVAL OF ANY ITEMS OF EQUIPMENT OR SYSTEMS THAT SHALL AFFECT OTHER SYSTEMS WITHIN THE LIMITS OF NEW CONSTRUCTION OR OTHER AREAS OF THE EXISTING BUILDING.
- WORK SHOWN ON THE DEMOLITION DRAWINGS DOES NOT ACCURATELY REFLECT ALL OF THE EXISTING CONDITIONS OR THE COMPLETE SCOPE OF THE DEMOLITION WORK. THIS WORK SHALL BE BASED ON THE DEMOLITION DRAWINGS, EXISTING DRAWINGS MADE AVAILABLE TO THE CONTRACTOR AND FIELD.
- THE DRAWINGS ONLY REFLECT KNOWN AREAS OF DEMOLITION. CONTRACTOR SHALL BE RESPONSIBLE FOR FIELD VERIFICATION OF THE COMPLETE SCOPE OF THE DEMOLITION WORK.
- CONTRACTOR SHALL TRACE ALL PIPING BACK TO MAIN RISERS AND/OR SUPPLIES, AND VERIFY THAT PIPING DOES NOT SERVE ANY OTHER FIXTURES TO REMAIN. CONTRACTOR SHALL OBTAIN APPROVAL FROM OWNERS REPRESENTATIVE PRIOR TO REMOVAL OF PIPING TO BE DEMOLISHED.
- FLUSH AND CLEAN ALL EXISTING FLOOR DRAINS, AREAWAY DRAINS, AND RELATED DRAINAGE PIPING AS PRECAUTION, AND AT THE COMPLETION OF THE PROJECT, TO PREVENT BLOCKAGE OF THE DRAINS WITH CONSTRUCTION DIRT, TRASH AND DEBRIS.
- CONTRACTOR SHALL PATCH AND REPAIR ALL WALLS, FLOORS AND CEILINGS TO MATCH EXISTING FINISHES OR PROPOSED NEW FINISHES, AS APPLICABLE, AND AS NECESSARY WHICH ARE AFFECTED BY THE REMOVAL AND/OR REWORK OF PLUMBING FIXTURES AND PIPING.

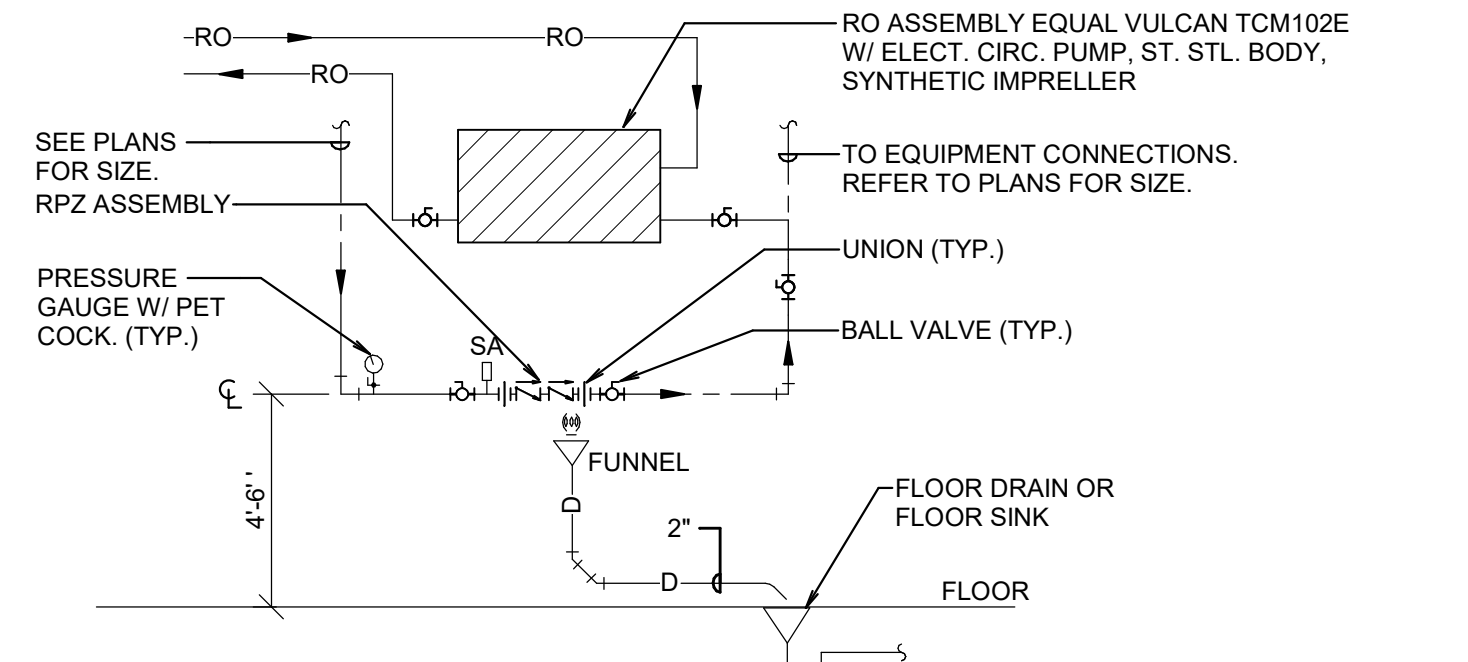

NOTES:

- ALL BACKFLOW PREVENTORS SHALL BE TESTED BY AN APPROVED BACKFLOW PREVENTION SPECIALIST PRIOR TO PLACING IN SERVICE. A CUSTOMER SERVICE INSPECTION CERTIFICATE SHALL BE REQUIRED PRIOR TO OBTAINING A CERTIFICATE OF OCCUPANCY PERMIT.

2 REDUCED PRESSURE BACKFLOW PREVENTER DETAIL  
NO SCALE

© This third copy or electronic drawing is an instrument of service and the property of Orcutt Winslow and shall remain their property. The design professional and not be responsible for any alterations, modifications or additions made to the drawing by any party other than the design professional. Use of this drawing shall be limited to the original use for which it was prepared and publication thereof is expressly limited to such use, in whole or in part. Unless otherwise agreed in writing, the design professional shall not be responsible for any other party's use of this drawing, and it may not be used for any other purpose without the design professional's written consent. Violation of any method or condition of use may result in legal action. Information obtained or constructed derived from this drawing shall be at the user's sole risk.



CLIENT CONTACT  
Midlothian ISD  
100 Walter Stephenson Rd.  
Midlothian, TX 76065

468-856-5000 T rola.fadel@msisd.gp

OWP PROJECT NO. DATE OF ISSUE  
2022-11-00 04.28.2022


REVISIONS	DESCRIPTION	DATE
1	Addendum 2	05/06/2022

PROJECT TEAM DRAWN BY  
ED TEXAS RWB

PROJECT PHASE  
CONSTRUCTION DOCUMENTS

SHEET CONTENTS  
PLUMBING  
SPECIFICATIONS,  
LEGEND & NOTES  
SHEET NO.



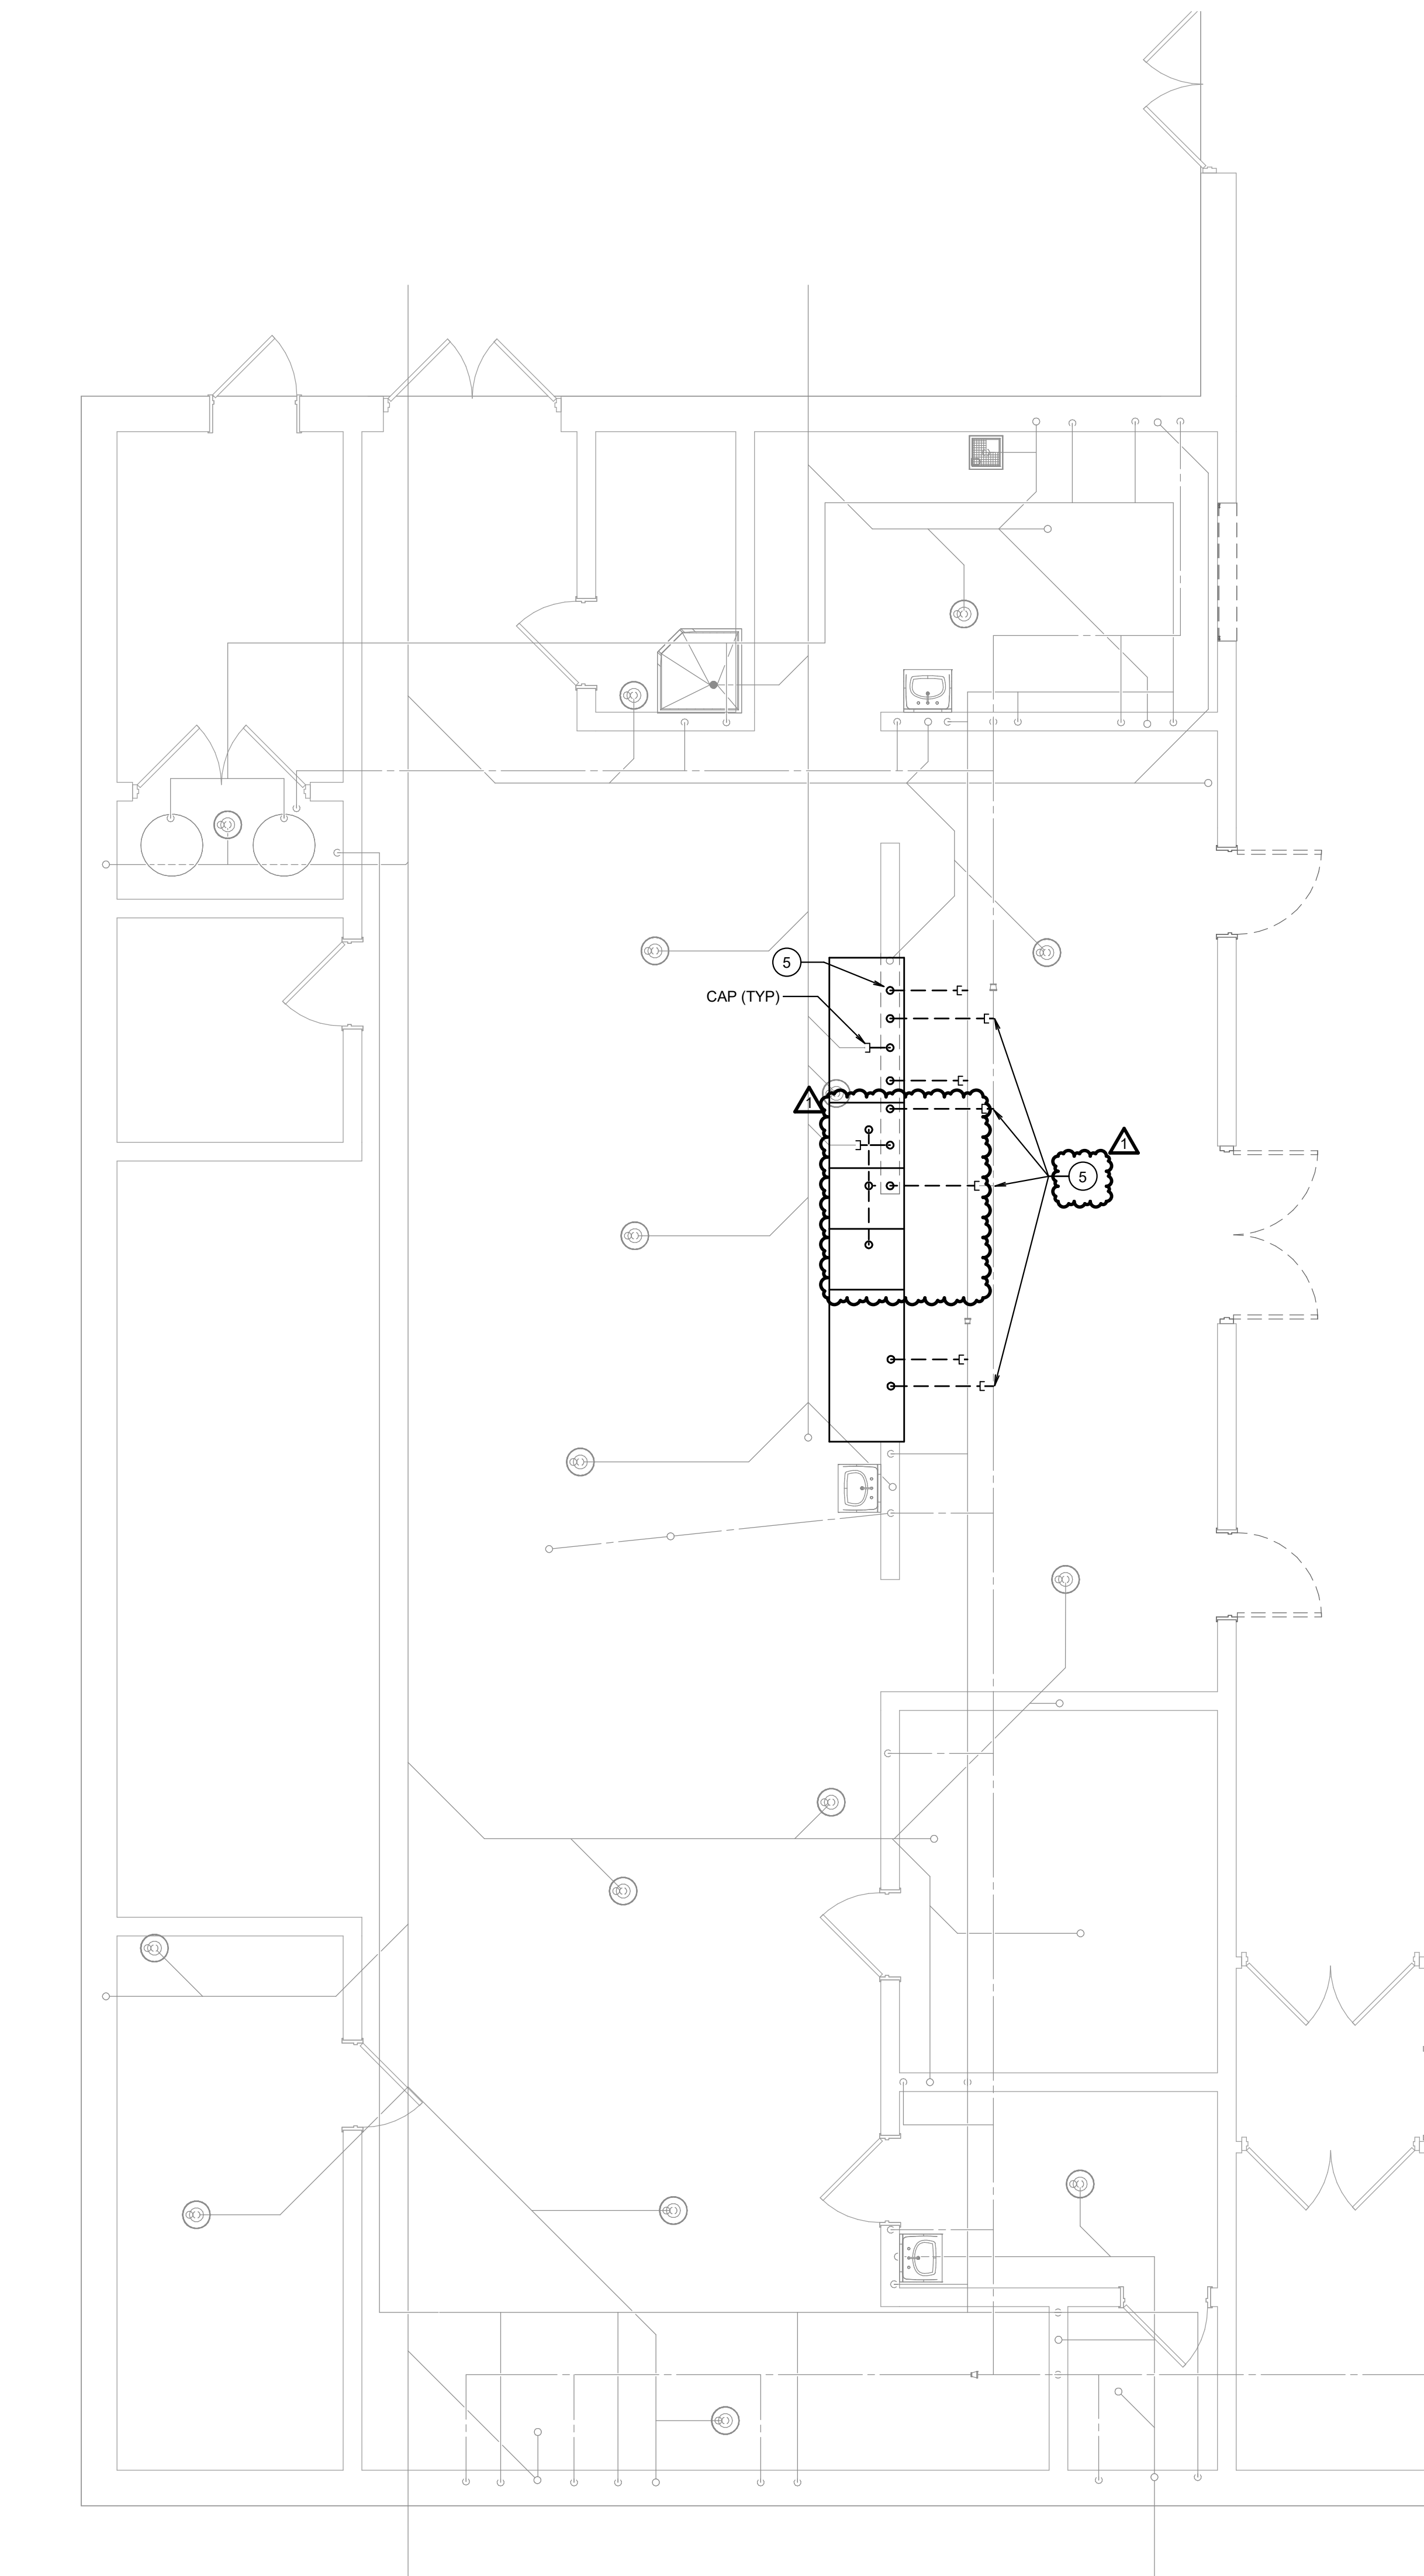

PLAN NORTH TRUE NORTH  
1 DEMOLITION FLOOR PLAN - LEVEL 1 - OVERALL - PLUMBING  
SCALE: 1/4" = 1'-0"


#### GENERAL FIRE SPRINKLER REWORK NOTE:

1. CONTRACTOR SHALL REWORK EXISTING WET SPRINKLER SYSTEM AS REQUIRED TO ACCOMMODATE AREAS OF NEW CONSTRUCTION, INCLUDING ALL AREAS OF RENOVATION. AREAS OF THE EXISTING BUILDING NOT CURRENTLY SPRINKLERED AND ADDITIONS. CONTRACTOR SHALL REWORK THE EXISTING FIRE RISER, FIRE HEADER, FIRE MAIN, DISTRIBUTION PIPING AND BRANCH PIPING AS REQUIRED IN ORDER TO ACCOMMODATE THE RENOVATED AREAS. AREAS OF NEW CONSTRUCTION AND AREAS OF THE BUILDING NOT CURRENTLY SPRINKLERED, RELOCATE AND / OR REPLACE EXISTING SPRINKER MAINS, BRANCH PIPING AND SPRINKLERS AS REQUIRED TO ACCOMMODATE CONSTRUCTION. PROVIDE NEW SPRINKLERS AS NECESSARY FOR COMPLETE COVERAGE. WHERE SPRINKLER PIPING IS REMOVED DISCONNECT & CAP ABOVE CEILING. CONTRACTOR SHALL FIELD VERIFY SCOPE OF WORK PRIOR TO BID SUBMITTAL.

PLUMBING EQUIPMENT ROUGH-IN CONNECTIONS ARE BASED ON ARCHITECT-PROVIDED EQUIPMENT SELECTIONS AND CUTSHEETS. CONTRACTOR TO REVIEW CUTSHEETS, CONFIRM CONNECTION REQUIREMENTS, AND FIELD VERIFY FIELD CONDITIONS AND REQUIREMENTS PRIOR TO PLUMBING ROUGH-IN. CONTRACTOR SHALL SUBMIT ANY AND ALL REQUIRED PLUMBING ROUGH-IN CONNECTION CHANGES TO ENGINEER PRIOR TO PLUMBING ROUGH-IN.

#### NOTES BY SYMBOL 'O':

- 1 SAWCUT EXISTING PIPING TO ACCOMMODATE NEW RO SYSTEM PIPING BELOW GRADE. ROUTE RO PIPING IN 3" PVC SLEEVE BELOW FLOOR. REFER TO DETAIL 'O1' ON SHEET P000.
- 2 RO ASSEMBLY AND RPZ. MOUNT RO ASSEMBLY ABOVE RPZ MAX 6'-0" AFF. REFER TO DETAIL 'O2' ON SHEET P000 FOR RPZ DETAIL. COORDINATE FINAL APPROVED LOCATION WITH ARCHITECT.
- 3 EXISTING BRAISING PAN AND STEAMER TO BE REPLACED. REWORK EXISTING DOMESTIC WATER AND DRAIN PIPING TO ACCOMMODATE NEW EQUIPMENT.
- 4 EXISTING COMBI OVEN TO BE REPLACED. REWORK EXISTING DOMESTIC WATER AND DRAIN PIPING TO ACCOMMODATE NEW EQUIPMENT.
- 5 EXISTING THREE COMPARTMENT SINK TO BE REMOVED AND RETURNED TO OWNER. REMOVE ASSOCIATED EXISTING SANITARY SEWER PIPING AND CAP BELOW FLOOR. REMOVE ASSOCIATED EXISTING VENT AND DOMESTIC WATER PIPING AND CAP ABOVE CEILING AT WATER MAIN.
- 6 CONTRACTOR SHALL INSTALL LOOSE IN-LINE FILTER AT ALL EQUIPMENT AS REQUIRED. REFER TO ARCHITECTURAL DRAWINGS AND EQUIPMENT CUTSHEETS FOR SCOPE OF WORK.

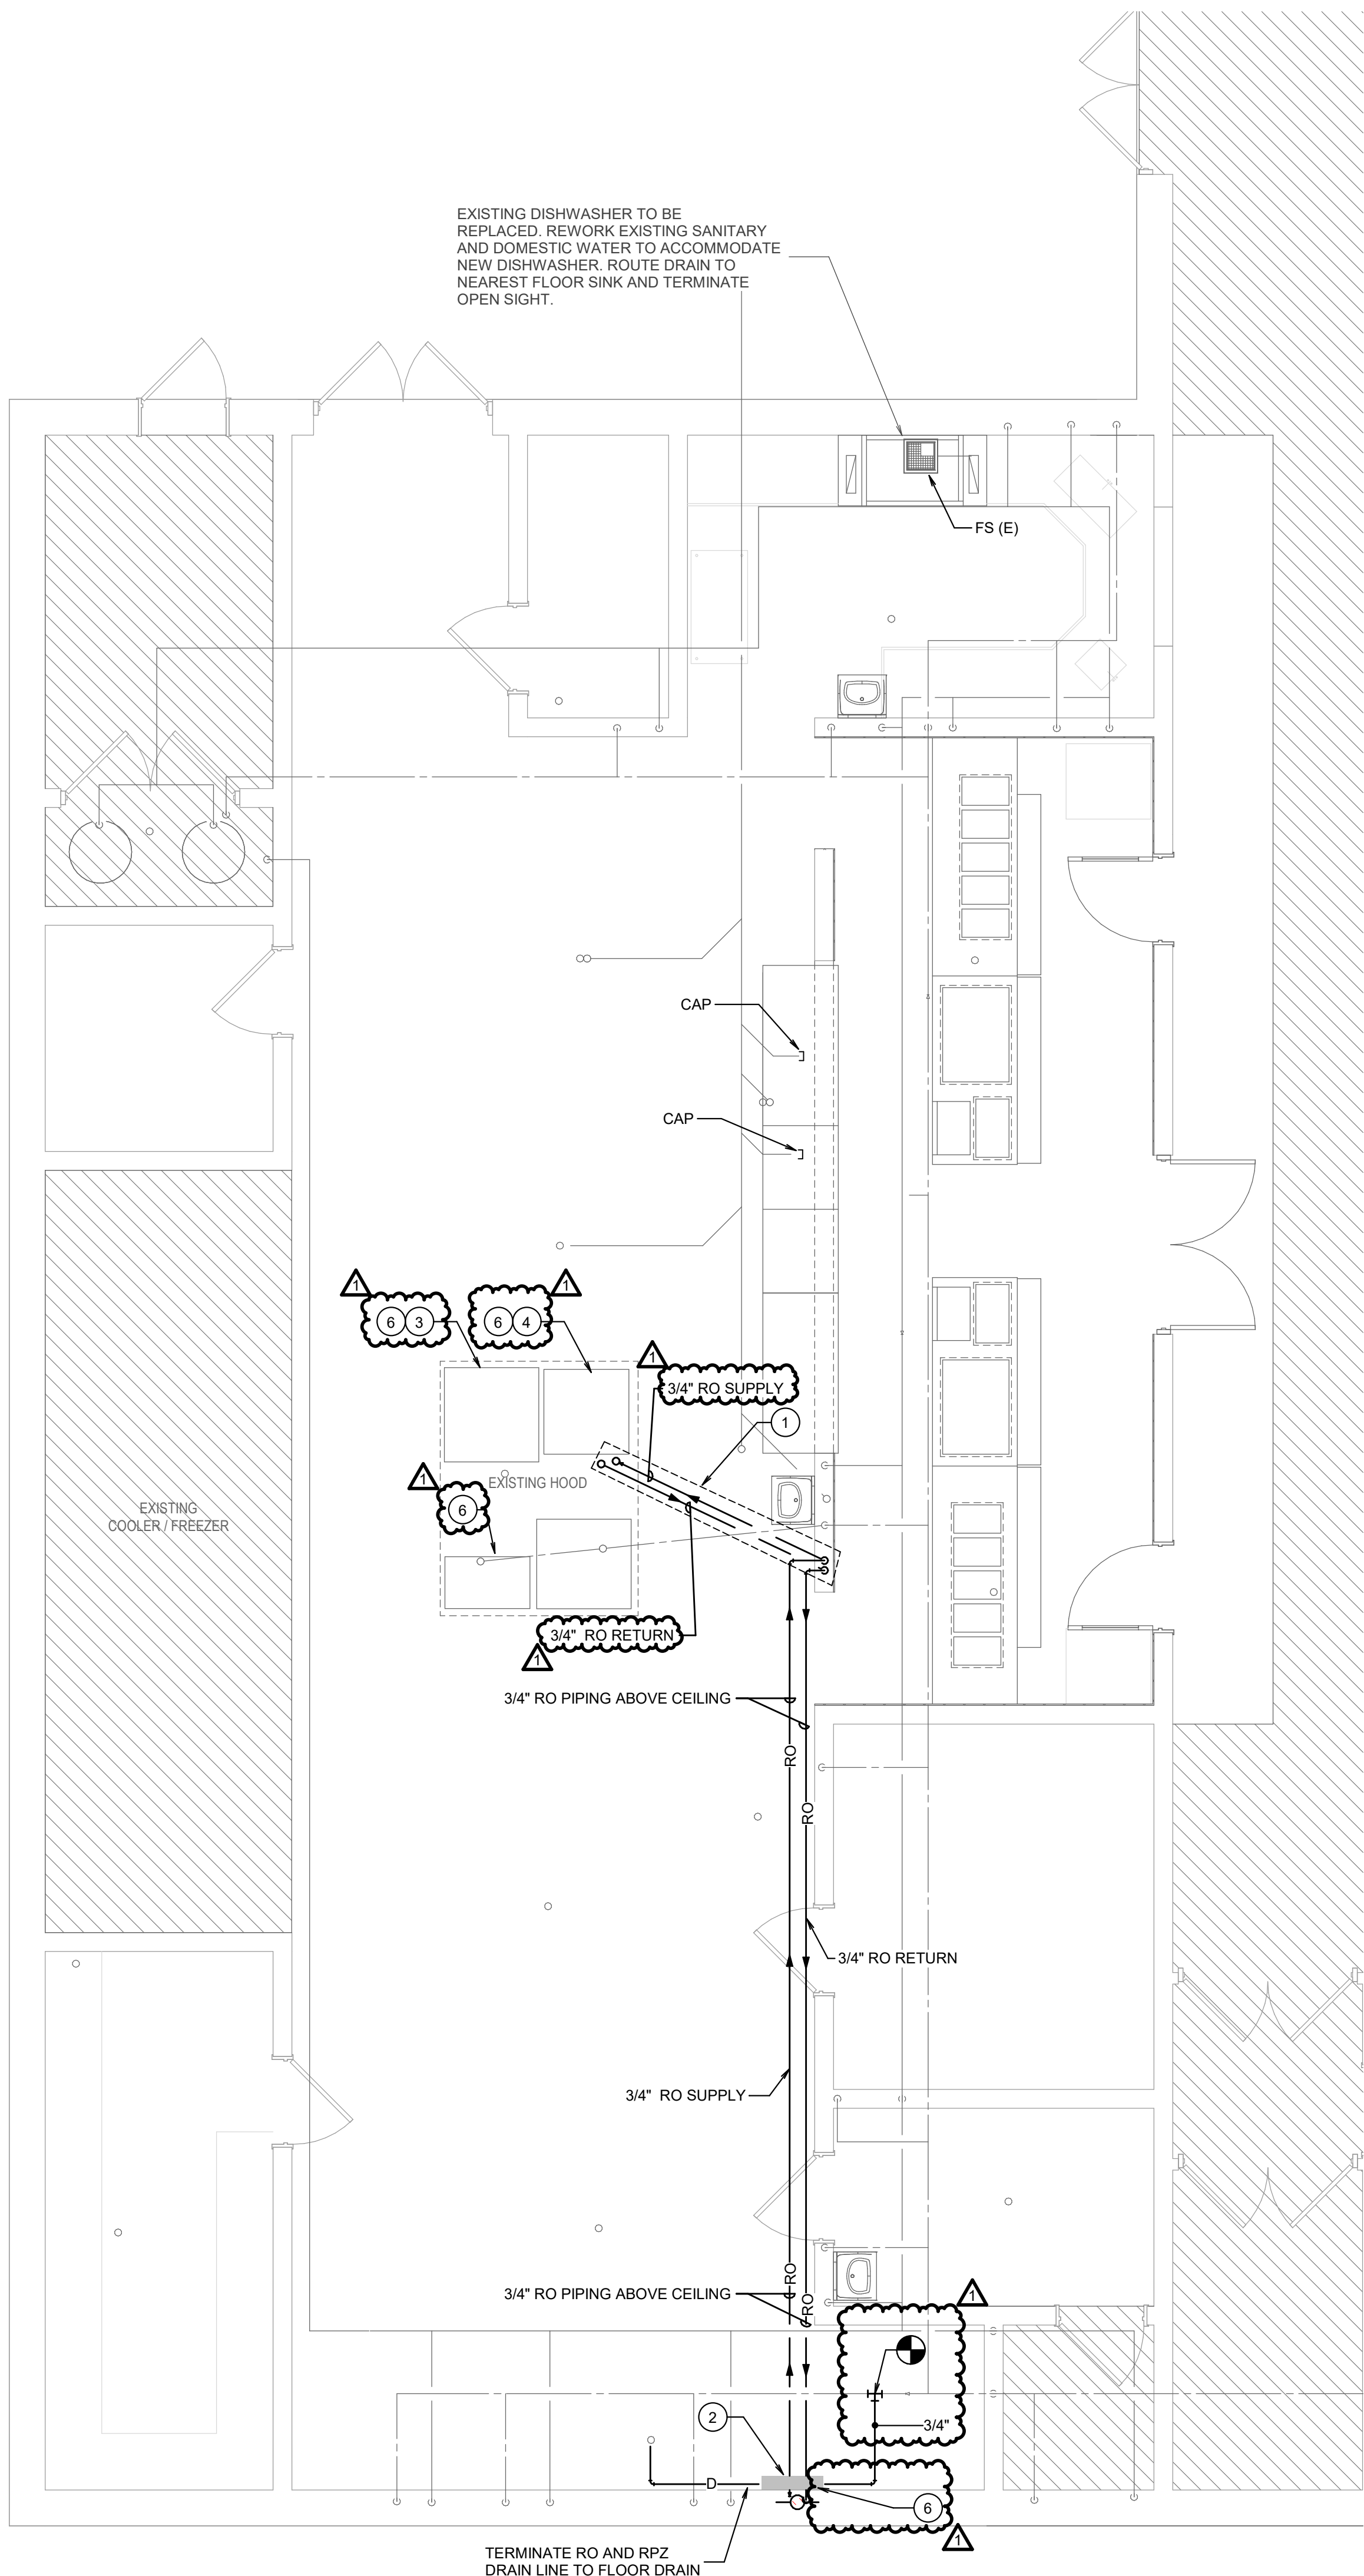

PLAN NORTH TRUE NORTH  
2 FLOOR PLAN - LEVEL 1 - OVERALL - PLUMBING  
SCALE: 1/4" = 1'-0"



# KITCHEN RENOVATION

1050 PARK PLACE BLVD.  
MIDLOTHIAN, TX 76065

CLIENT CONTACT  
Midlothian ISD  
100 Walter Stephenson Rd.  
Midlothian, TX 76065  
468-856-5000 T rola.fadel@midis.g

OWP PROJECT NO. DATE OF ISSUE  
2022-110-00 04.28.2022

REVISIONS	DELTA	DESCRIPTION	DATE
1	Addendum 2		05/06/2022

PROJECT TEAM  
ED TEXAS

DRAWN BY  
Author

PROJECT PHASE  
CONSTRUCTION DOCUMENTS

SHEET CONTENTS  
FLOOR PLAN - LEVEL 1 -  
PLUMBING

SHEET NO.

P100



GENERAL DEMOLITION NOTES:

1. REFER TO GENERAL DEMOLITION NOTES ON SHEET E000.

DEMOLITION NOTES BY SYMBOL '○':

1. DISCONNECT AND REMOVE POWER FOR BOOSTER HEATER ALONG WITH ASSOCIATED WIRE AND CONDUIT BACK TO SOURCE.
2. DISCONNECT AND REMOVE POWER FOR EXISTING DISHWASHER ALONG WITH ASSOCIATED WIRE AND CONDUIT BACK TO SOURCE.
3. DISCONNECT AND REMOVE POWER FOR EXISTING DISPOSER ALONG WITH ASSOCIATED WIRE AND CONDUIT BACK TO SOURCE.
4. DISCONNECT AND REMOVE POWER FOR EXISTING PASS THRU HEATER ALONG WITH ASSOCIATED WIRE AND CONDUIT BACK TO SOURCE.
5. DISCONNECT AND REMOVE POWER FOR EXISTING PASS THRU HEATED CABINET ALONG WITH ASSOCIATED WIRE AND CONDUIT BACK TO SOURCE.
6. DISCONNECT AND REMOVE POWER FOR EXISTING PASS THRU REFRIGERATED CABINET ALONG WITH ASSOCIATED WIRE AND CONDUIT BACK TO SOURCE.
7. DISCONNECT AND REMOVE POWER FOR EXISTING BRAISING PAN ALONG WITH ASSOCIATED WIRE BACK TO SOURCE.

DEMOLITION NOTES BY SYMBOL '○':



8. DISCONNECT AND REMOVE POWER FOR EXISTING COMBI DOUBLE OVEN ALONG WITH ASSOCIATED WIRE BACK TO SOURCE.
9. DISCONNECT AND REMOVE POWER FOR EXISTING CONVECTION OVEN ALONG WITH ASSOCIATED WIRE BACK TO SOURCE.
10. DISCONNECT AND REMOVE POWER FOR EXISTING CONVECTION STEAMER ALONG WITH ASSOCIATED WIRE BACK TO SOURCE.
11. DISCONNECT AND REMOVE POWER FOR EXISTING SERVING LINE ALONG WITH ASSOCIATED WIRE BACK TO SOURCE.
12. TEMPORARILY SUPPORT ALL CEILING MOUNTED FIRE ALARM DEVICES AND OTHER LOW VOLTAGE DEVICES DURING THE REPLACEMENT OF EXISTING CEILING. PROTECT DEVICES FROM DEBRIS AND DAMAGE DURING RENOVATION. REINSTALL ON NEW CEILING.

GENERAL POWER NOTES:



1. REFER TO GENERAL POWER NOTES ON SHEET E000.

NOTES BY SYMBOL '○':


1. PROVIDE NEW STAINLESS STEEL DISCONNECT SWITCHES.
2. REUSE EXISING FLOOR STUB-UP CONDUIT FOR NEW KITCHEN EQUIPMENT.
3. TEMPORARILY SUPPORT ALL CEILING MOUNTED FIRE ALARM DEVICES AND OTHER LOW VOLTAGE DEVICES DURING THE REMOVAL AND REPLACEMENT OF EXISTING CEILING. PROTECT DEVICES FROM DEBRIS AND DAMAGE DURING RENOVATION. REINSTALL ON NEW CEILING.
4. POWER FOR NEW 50A/3P MAIN CIRCUIT BREAKER LOAD CENTER FOR NEW SERVING LINE POWER. SERVING LINE LOAD CENTER SHALL BE SUPPLIED WITH SERVING LINE EQUIPMENT. COORDINATE EXACT LOCATION OF SERVING LINE LOAD CENTER WITH KITCHEN EQUIPMENT SUPPLIER.
5. SAW CUT EXISTING CONCRETE SLAB FOR NEW SERVING LINE POWER. CONTRACTOR SHALL XRAY CONCRETE SLAB AND COORDINATE WITH EXISTING UTILITIES.

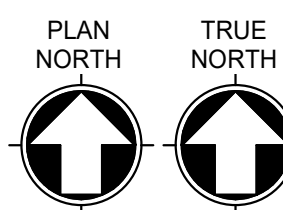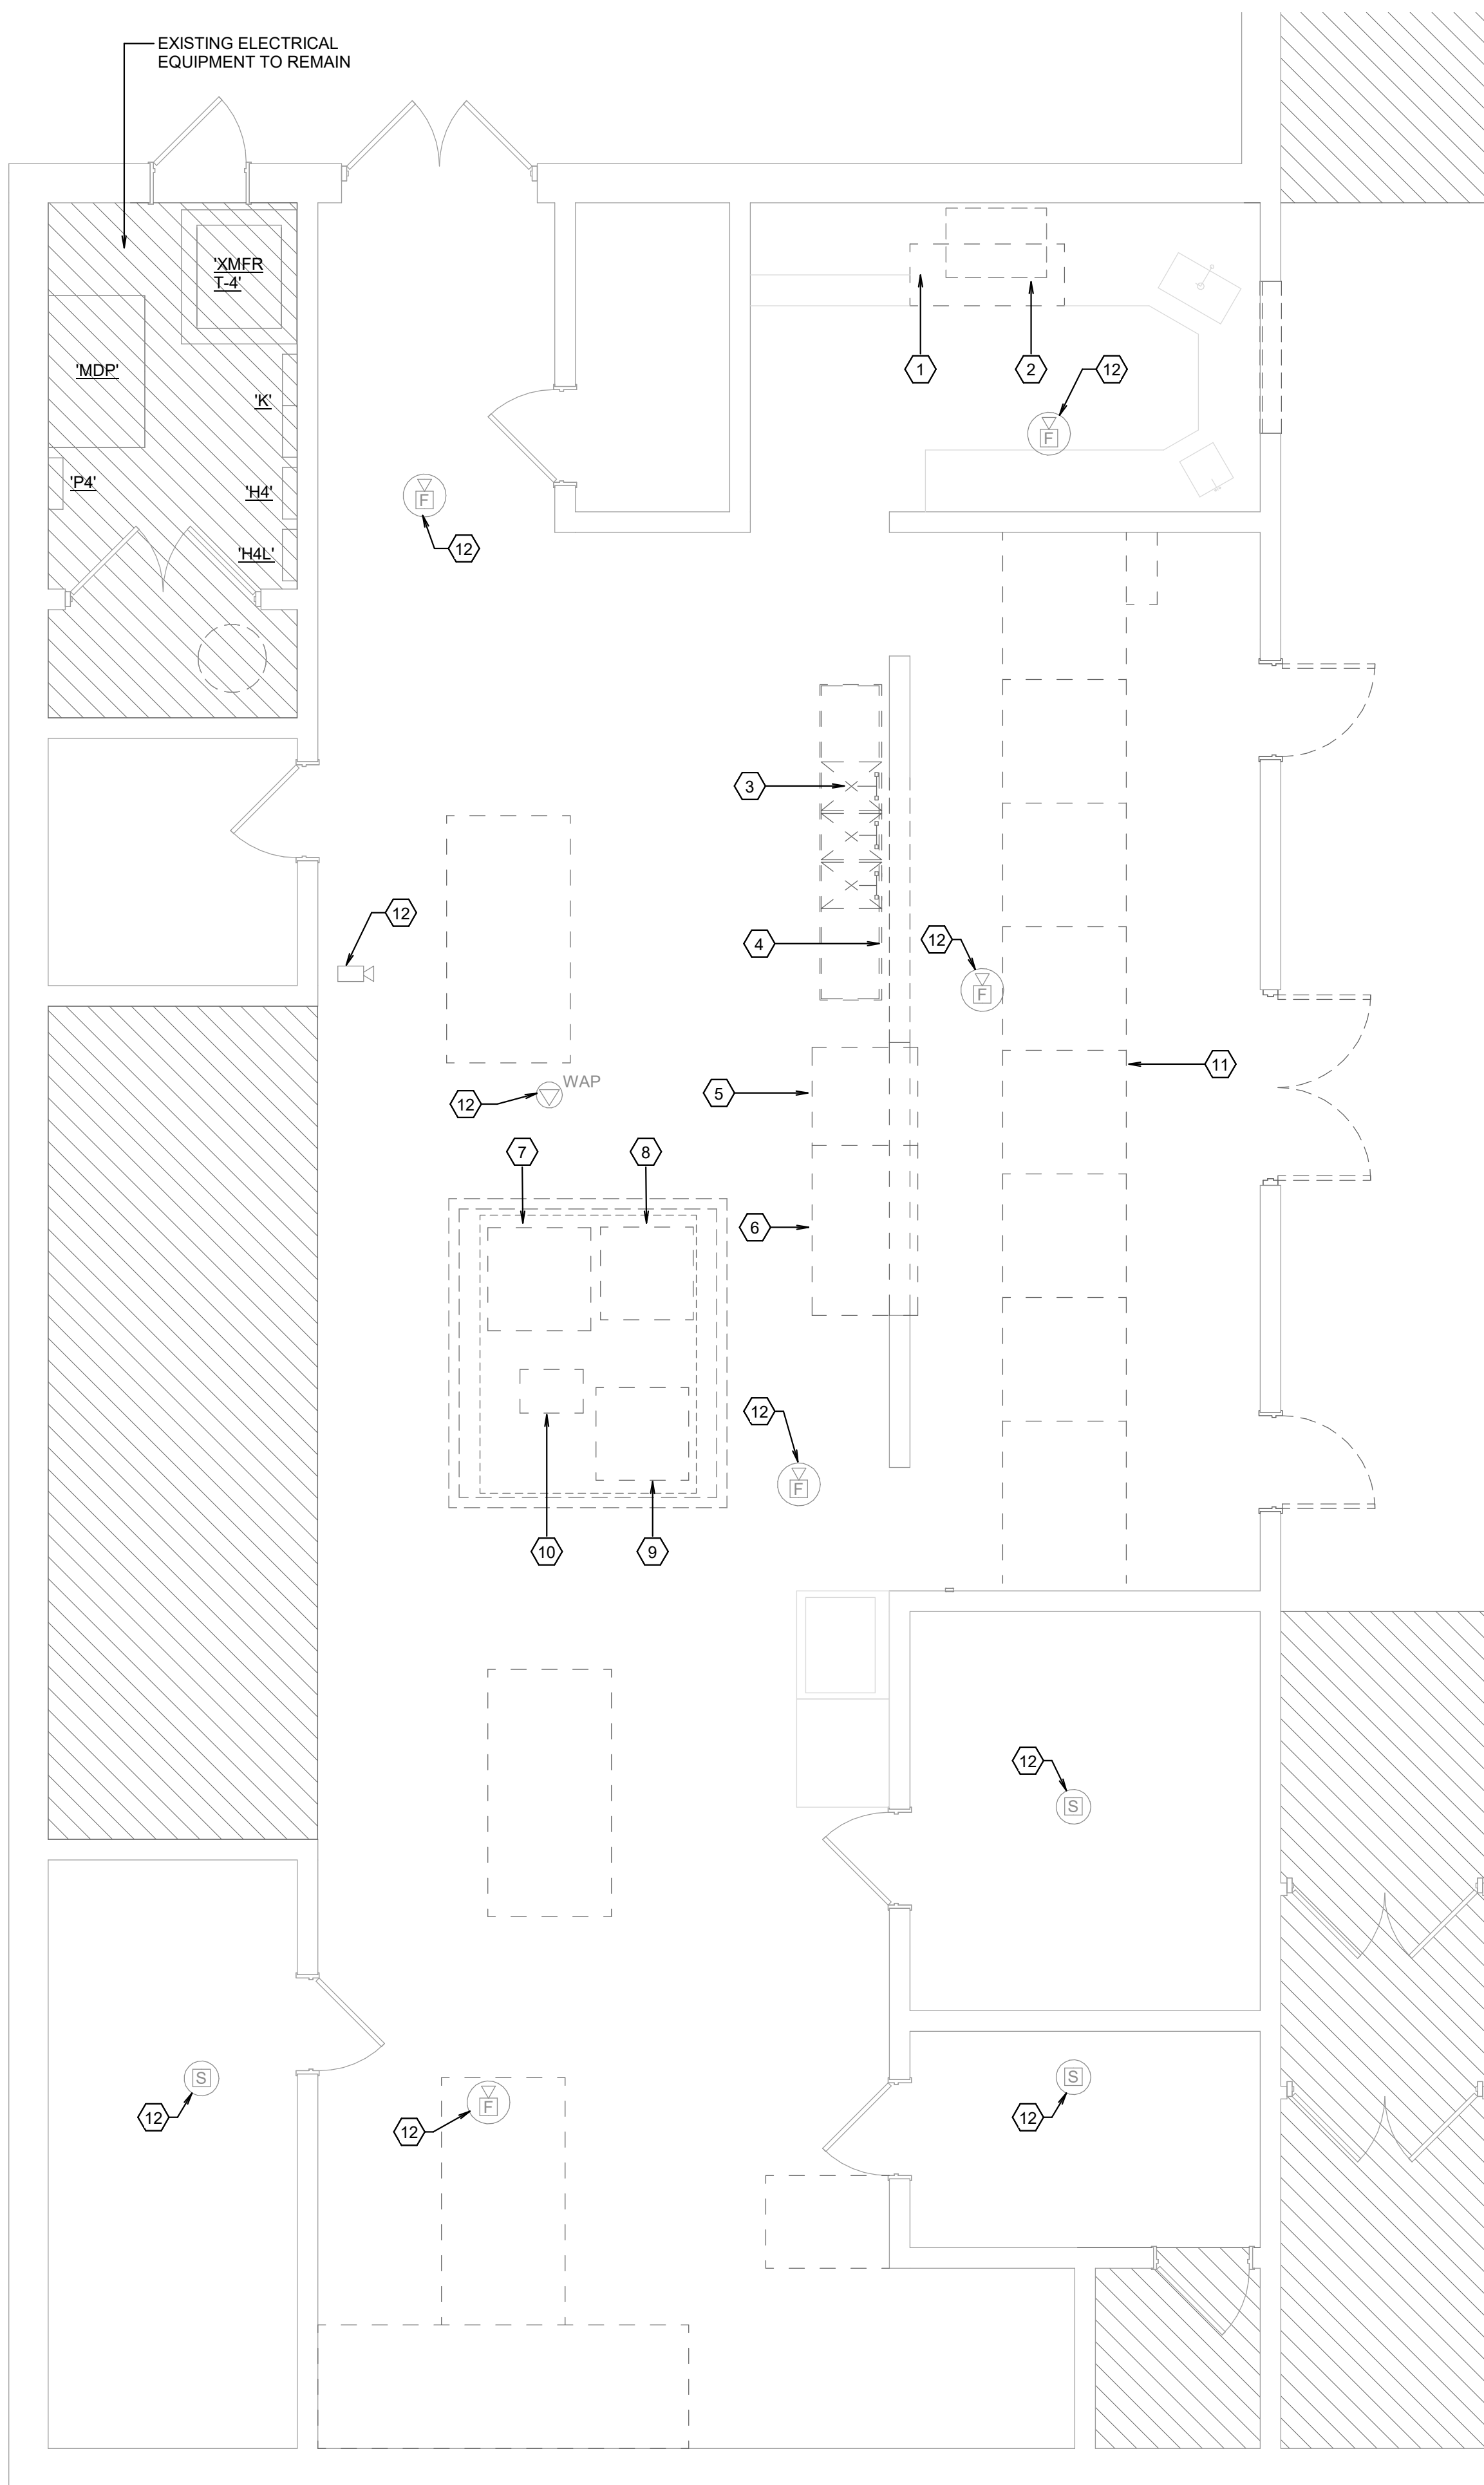

DEMOLITION FLOOR PLAN - LEVEL 1 - OVERALL - ELECTRICAL  
SCALE: 1/4" = 1'-0"

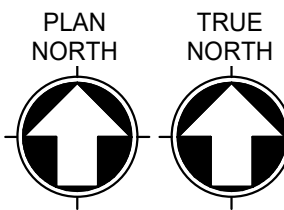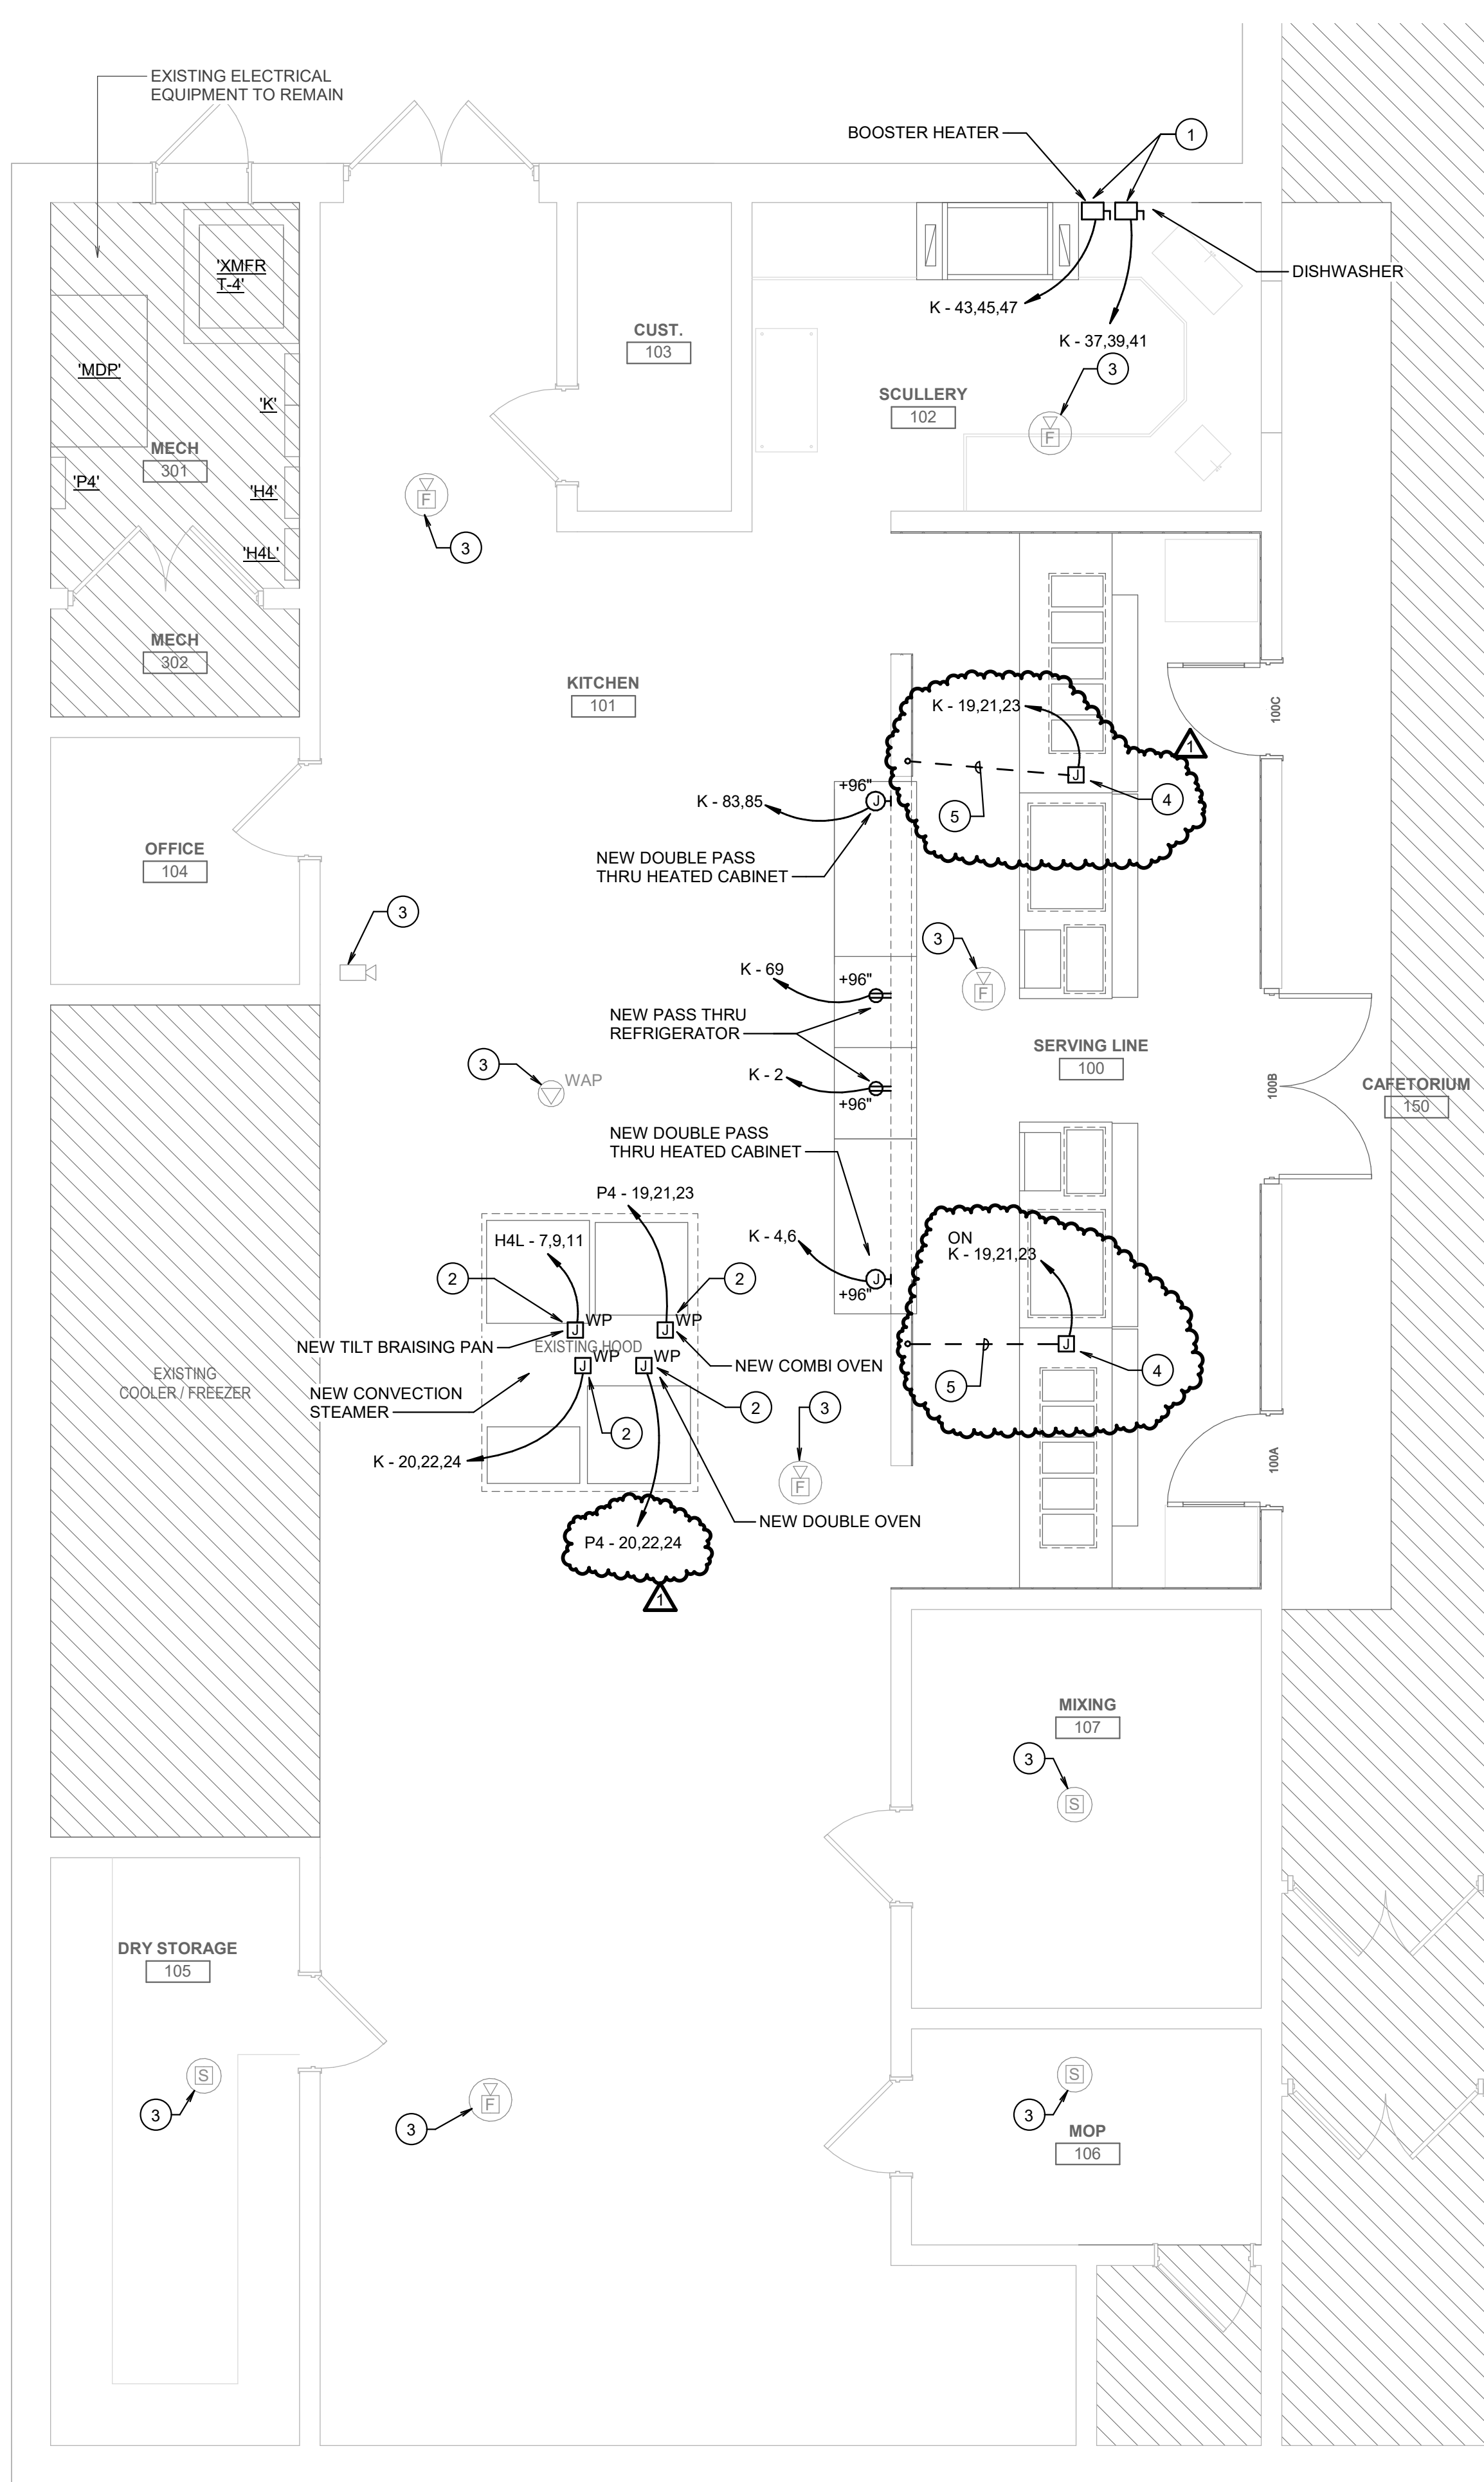

FLOOR PLAN - LEVEL 1 - OVERALL - ELECTRICAL  
SCALE: 1/4" = 1'-0"

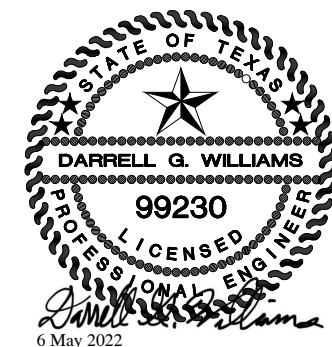

KITCHEN RENOVATION  
1050 PARK PLACE BLVD.  
MIDLOTHIAN, TX 76065

CLIENT CONTACT  
Midlothian ISD  
100 Walter Stephenson Rd.  
Midlothian, TX 76065  
468-856-5000 T rola.fadel@mid.isd.net

OWP PROJECT NO. DATE OF ISSUE  
2022-110-00 04.28.2022

REVISIONS	DATE
DELTA	05/06/2022
1	Addendum 2

PROJECT TEAM  
ED TEXAS  
RWB

PROJECT PHASE  
CONSTRUCTION DOCUMENTS

SHEET CONTENTS  
FLOOR PLAN - LEVEL 1 - ELECTRICAL

SHEET NO.

E100





Consulting Engineers  
12001 N Central Expy  
Suite 1100  
Dallas, TX 75243

12100 EPH-2170  
(972) 788-4222  
Project 2024-00

222 w las colinas blvd

suite 749e

irving, tx 75039


mail@owp.com

214.396.2090 t

www.owp.com

orcutt | winslow

© This (hard copy or electronic) drawing is an instrument of service and the property of Orcutt Winslow and shall remain their property. The design professional shall not be responsible for any alterations, modifications or additions made to this drawing by any party other than the design professional. Use of this drawing shall be limited to the original intent for which it was prepared and no other purpose without the design professional's written consent. Reproduction by any method without the design professional's written consent is prohibited. Any information obtained or conclusions derived from this drawing shall be the user's sole risk.

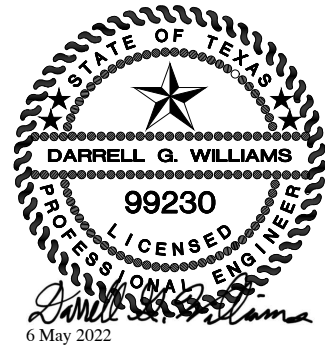

T E BAXTER ELEMENTARY SCHOOL

# KITCHEN RENOVATION

1050 PARK PLACE BLVD.  
MIDLOTHIAN, TX 76065

CLIENT CONTACT  
Midlothian ISD  
100 Walter Stephenson Rd.  
Midlothian, TX 76065

468-856-5000 T rola.fadel@midisd.g

OWP PROJECT NO. DATE OF ISSUE  
2022-110-00 04.28.2022

REVISIONS

DELTA	DESCRIPTION	DATE
1	Addendum 2	05/06/2022

PROJECT TEAM  
ED TEXAS

DRAWN BY  
RWB

PROJECT PHASE  
CONSTRUCTION DOCUMENTS

SHEET CONTENTS  
LIGHT FIXTURE &  
PANEL SCHEDULES

SHEET NO.

E700

## PANEL: K (EXISTING)

Location: MECH 301  
Supply From:  
Mounting: SURFACE  
Enclosure: NEMA 1

Volts: 120/208 Wye  
Phases: 3  
Wires: 4  
Sections: 2

A.I.C. Rating: 10,000 A.I.C.  
Mains Type: MLO  
Mains Rating: 600.0 A

CKT	REM	Load Name	BKR	Poles	Wire Size	A	B	C	Wire Size	Poles	BKR	Load Name	REM	CKT
1	--	EXISTING LOAD	100	2	--	0	840	0	1643	--	2	NEW PASS THRU...	--	2
3	--	SPACE	--	1	--					--	25	NEW DOUBLE ROLL THRU HEATED...	--	4
5	--	SPACE	--	1	--					--	40	EXISTING LOAD	--	8
7	--	EXISTING LOAD	15	3	--	0	0	0	0	--	2	EXISTING LOAD	--	10
9	--	EXISTING LOAD	15	3	--	0	0	0	0	--	20	EXISTING LOAD	--	12
11	--	EXISTING LOAD	15	3	--	0	0	0	0	--	20	EXISTING LOAD	--	14
13	--	EXISTING LOAD	15	3	--	0	0	0	0	--	20	EXISTING LOAD	--	16
15	--	EXISTING LOAD	15	3	--	0	0	0	0	--	20	EXISTING LOAD	--	18
17	--	EXISTING LOAD	15	3	--	0	0	0	0	--	20	EXISTING LOAD	--	20
19	2	Power to (2) New Kitchen Serving Lines	100	3	4#2, 1#8G-1 1/4"C.	4080	2667	4080	2667	3#8, 1#10G-EXISTING CONDUIT	3	CONVECTION STEAMER	2,5	22
21	--	EXISTING LOAD	15	3	--	0	0	0	0	--	1	EXISTING LOAD	--	24
23	--	EXISTING LOAD	15	3	--	0	0	0	0	--	1	EXISTING LOAD	--	26
25	--	EXISTING LOAD	15	3	--	0	0	0	0	--	1	EXISTING LOAD	--	28
27	--	EXISTING LOAD	15	3	--	0	0	0	0	--	1	EXISTING LOAD	--	30
29	--	EXISTING LOAD	20	1	--	0	0	0	0	--	3	EXISTING LOAD	--	32
31	--	EXISTING LOAD	20	1	--	0	0	0	0	--	3	EXISTING LOAD	--	34
33	--	EXISTING LOAD	20	1	--	0	0	0	0	--	3	EXISTING LOAD	--	36
35	--	EXISTING LOAD	20	1	--	0	0	0	0	--	3	EXISTING LOAD	--	38
37	2	NEW DISHWASHER	60	3	REUSE EXISTING	5000	0	5000	0	--	3	EXISTING LOAD	--	40
39	--	EXISTING LOAD	20	1	--	0	0	0	0	--	1	SPACE	--	42
41	--	EXISTING LOAD	20	1	--	0	0	0	0	--	1	SPACE	--	44
43	2	NEW 30KW BOOSTER HEATER	90	3	3#3, 1#8G-1 1/4"C.	10064	--	10064	0	--	2	EXISTING LOAD	--	46
45	--	EXISTING LOAD	50	2	--	0	0	0	0	--	1	EXISTING LOAD	--	48
47	--	EXISTING LOAD	20	1	--	0	0	0	0	--	1	EXISTING LOAD	--	50
49	--	EXISTING LOAD	20	1	--	0	0	0	0	--	1	EXISTING LOAD	--	52
51	--	EXISTING LOAD	20	1	--	0	0	0	0	--	1	EXISTING LOAD	--	54
53	--	EXISTING LOAD	20	1	--	0	0	0	0	--	1	EXISTING LOAD	--	56
55	--	EXISTING LOAD	20	1	--	0	0	0	0	--	1	EXISTING LOAD	--	58
57	--	EXISTING LOAD	20	1	--	0	0	0	0	--	1	EXISTING LOAD	--	60
59	--	EXISTING LOAD	20	1	--	0	0	0	0	--	1	EXISTING LOAD	--	62
61	--	EXISTING LOAD	20	1	--	0	0	0	0	--	1	EXISTING LOAD	--	64
63	--	EXISTING LOAD	20	1	--	0	0	0	0	--	1	EXISTING LOAD	--	66
65	--	EXISTING LOAD	20	1	--	0	0	0	0	--	1	EXISTING LOAD	--	68
67	--	EXISTING LOAD	20	1	--	0	0	0	0	--	1	EXISTING LOAD	--	70
69	--	NEW PASS THRU...	20	1	--	0	840	0	0	--	1	EXISTING LOAD	--	72
71	--	EXISTING LOAD	20	1	--	0	0	0	0	--	1	EXISTING LOAD	--	74
73	--	EXISTING LOAD	20	1	--	0	0	0	0	--	1	EXISTING LOAD	--	76
75	--	EXISTING LOAD	20	1	--	0	0	0	0	--	1	EXISTING LOAD	--	78
77	--	EXISTING LOAD	20	1	--	0	0	0	0	--	1	EXISTING LOAD	--	80
79	--	EXISTING LOAD	50	2	--	0	0	0	0	--	1	EXISTING LOAD	--	82
81	2	NEW DOUBLE ROLL THRU HEATED...	25	2	2#10, 1#1-G-3/4"C.	1643	0	1643	0	--	2	EXISTING LOAD	--	84
83	--	EXISTING LOAD	20	1	--	0	0	0	0	--	3	EXISTING LOAD	--	86
85	--	EXISTING LOAD	30	3	--	0	0	0	0	--	3	EXISTING LOAD	--	88
87	--	EXISTING LOAD	30	3	--	0	0	0	0	--	3	EXISTING LOAD	--	90
89	--	EXISTING LOAD	30	3	--	0	0	0	0	--	3	EXISTING LOAD	--	92
91	--	EXISTING LOAD	30	3	--	0	0	0	0	--	3	EXISTING LOAD	--	94
Total Load:						24,293 VA	24,293 VA	25,096 VA						
Total Amps:						202.4 A	202.4 A	209.1 A						

Load Classification	Connected Load	Demand Factor	Estimated Demand	Panel Totals
Kitchen Equipment	72,843 VA	65.00%	47,346 VA	Total Conn. Load: 73,883 VA
Receptacle	840 VA	100.00%	840 VA	Total Est. Demand: 48,188 VA
				Total Conn. Current: 204.5 A
				Total Est. Demand Current: 133.8 A

### General Notes:

- A. PROVIDE FEED-THROUGH LUGS FOR FUTURE EXPANSION.  
B. PROVIDE FULL SIZED PHASE, NEUTRAL AND GROUND BUSES.  
C. THE CONTRACTOR SHALL UPDATE ROOM NAMES AND ROOM NUMBERS ON FINAL PANEL SCHEDULE TO REFLECT FINAL BUILDING CONDITIONS.

### Remarks:

1. PROVIDE GFCI CIRCUIT BREAKER.  
2. PROVIDE CIRCUIT BREAKER AND / OR FUSES PER EQUIPMENT MANUFACTURER'S SPECIFICATIONS.  
3. BRANCH CIRCUIT SHALL BE 2 #12 & #12 GROUND IN 3/4" CONDUIT.  
4. BRANCH CIRCUIT ROUTED THROUGH AND CONTROLLED BY SECONDARY CONTACTOR.  
5. PROVIDE WITH SHUNT TRIP BREAKER.  
6. PROVIDE CIRCUIT BREAKER CAPABLE OF BEING LOCKED IN THE OFF POSITION.

## PANEL: P4 (EXISTING)

Location: MECH 301  
Supply From:  
Mounting: SURFACE  
Enclosure: NEMA 1

Volts: 480/277 Wye  
Phases: 3  
Wires: 4  
Sections: 1

A.I.C. Rating: 14,000 A.I.C.  
Mains Type: MCB  
Mains Rating: 400.0 A

CKT	REM	Load Name	BKR	Poles	Wire Size	A	B	C	Wire Size	Poles	BKR	Load Name	REM	CKT
1	--	EXISTING LOAD	20	3	--	0	0	0	0	--	3	EXISTING LOAD	--	2
3	--	EXISTING LOAD	20	3	--	0	0	0	0	--	3	EXISTING LOAD	--	4
5	--	EXISTING LOAD	20	3	--	0	0	0	0	--	3	EXISTING LOAD	--	6
7	--	EXISTING LOAD	20	3	--	0	0	0	0	--	3	EXISTING LOAD	--	8
9	--	EXISTING LOAD	20	3	--	0	0	0	0	--	3	EXISTING LOAD	--	10
11	--	EXISTING LOAD	20	3	--	0	0	0	0	--	3	EXISTING LOAD	--	12
13	--	EXISTING LOAD	30	3	--	0	0	0	0	--	3	EXISTING LOAD	--	14
15	--	EXISTING LOAD	30	3	--	0	0	0	0	--	3	EXISTING LOAD	--	16
17	--	EXISTING LOAD	30	3	--	0	0	0	0	--	3	EXISTING LOAD	--	18
19	2,5	NEW COMBI OVEN	50	3	3#8, 1#10G-1"C	10388	8333	10388	8333	3#8, 1#10G-3/4"C	3	NEW DOUBLE CONV OVEN	2,5	20
21	--	SPACE	--	1	--					--	1	SPACE	--	22
23	--	SPACE	--	1	--					--	1	SPACE	--	24
25	--	SPACE	--	1	--					--	1	SPACE	--	26
27	--	SPACE	--	1	--					--	1	SPACE	--	28
Total Load:						18,721 VA	18,721 VA	18,721 VA						
Total Amps:						67.6 A	67.6 A	67.6 A						

Load Classification	Connected Load	Demand Factor	Estimated Demand	Panel Totals
Kitchen Equipment	56,163 VA	100.00%	56,163 VA	Total Conn. Load: 56,163 VA
				Total Est. Demand: 56,163 VA
				Total Conn. Current: 67.6 A
				Total Est. Demand Current: 67.6 A

### General Notes:

- A. PROVIDE FEED-THROUGH LUGS FOR FUTURE EXPANSION.  
B. PROVIDE FULL SIZED PHASE, NEUTRAL AND GROUND BUSES.  
C. THE CONTRACTOR SHALL UPDATE ROOM NAMES AND ROOM NUMBERS ON FINAL PANEL SCHEDULE TO REFLECT FINAL BUILDING CONDITIONS.

### Remarks:

1. PROVIDE GFCI CIRCUIT BREAKER.  
2. PROVIDE CIRCUIT BREAKER AND / OR FUSES PER EQUIPMENT MANUFACTURER'S SPECIFICATIONS.  
3. BRANCH CIRCUIT SHALL BE 2 #12 & #12 GROUND IN 3/4" CONDUIT.  
4. BRANCH CIRCUIT ROUTED THROUGH AND CONTROLLED BY SECONDARY CONTACTOR.  
5. PROVIDE WITH SHUNT TRIP BREAKER.  
6. PROVIDE CIRCUIT BREAKER CAPABLE OF BEING LOCKED IN THE OFF POSITION.

## PANEL: H4 (EXISTING)

Location: MECH 301  
Supply From:  
Mounting: SURFACE  
Enclosure: NEMA 1

Volts: 480/277 Wye  
Phases: 3  
Wires: 4  
Sections: 1

A.I.C. Rating: 14,000 A.I.C.  
Mains Type: MLO  
Mains Rating: 100.0 A

CKT	REM	Load Name	BKR	Poles	Wire Size	A			B			C			Wire Size	Poles	BKR	Load Name	REM	CKT
1	--	SPACE	--	3	--	--	0	--	--	0	--	--	0	--	--	3	70	EXISTING LOAD	--	2
3	--	SPACE	--	3	--	--	0	--	--	0	--	--	0	--	--	3	70	EXISTING LOAD	--	4
5	--	SPACE	--	3	--	--	0	--	--	0	--	--	0	--	--	3	70	EXISTING LOAD	--	6
7	--	EXISTING LOAD	40	3	--	0	0	0	0	0	0	0	0	--	1	20	EXISTING LOAD	--	8	
9	--	EXISTING LOAD	40	3	--	0	0	0	0	0	0	0	0	--	1	20	EXISTING LOAD	--	10	
11	--	EXISTING LOAD	20	1	--	0	0	0	0	0	0	0	0	--	1	20	EXISTING LOAD	--	12	
13	--	EXISTING LOAD	20	1	--	0	0	0	0	0	0	0	0	--	1	20	EXISTING LOAD	--	14	
15	--	EXISTING LOAD	20	1	--	0	0	0	0	0	0	0	0	--	1	20	EXISTING LOAD	--	16	
17	--	EXISTING LOAD	20	1	--	0	0	0	0	0	0	0	0	--	1	20	EXISTING LOAD	--	18	
19	--	EXISTING LOAD	20	1	--	0	0	0	0	0	0	0	0	--	1	20	EXISTING LOAD	--	20	
21	--	EXISTING LOAD	20	1	--	0	0	0	0	0	0	0	0	--	1	20	EXISTING LOAD	--	22	
23	--	EXISTING LOAD	20	1	--	0	0	0	0	0	0	0	0	--	1	20	EXISTING LOAD	--	24	
Total Load:						0 VA	0 VA	0 VA												
Total Amps:						0.0 A	0.0 A	0.0 A												

Load Classification	Connected Load	Demand Factor	Estimated Demand	Panel Totals
				Total Conn. Load: 0 VA
				Total Est. Demand: 0 VA
				Total Conn. Current: 0.0 A
				Total Est. Demand Current: 0.0 A

### General Notes:

- A. PROVIDE FEED-THROUGH LUGS FOR FUTURE EXPANSION.  
B. PROVIDE FULL SIZED PHASE, NEUTRAL AND GROUND BUSES.  
C. THE CONTRACTOR SHALL UPDATE ROOM NAMES AND ROOM NUMBERS ON FINAL PANEL SCHEDULE TO REFLECT FINAL BUILDING CONDITIONS.

### Remarks:

1. PROVIDE GFCI CIRCUIT BREAKER.  
2. PROVIDE CIRCUIT BREAKER AND / OR FUSES PER EQUIPMENT MANUFACTURER'S SPECIFICATIONS.  
3. BRANCH CIRCUIT SHALL BE 2 #12 & #12 GROUND IN 3/4" CONDUIT.  
4. BRANCH CIRCUIT ROUTED THROUGH AND CONTROLLED BY SECONDARY CONTACTOR.  
5. BRANCH CIRCUIT ROUTED THROUGH AND CONTROLLED BY UTILITY LAB CONTROLLER.  
6. PROVIDE CIRCUIT BREAKER CAPABLE OF BEING LOCKED IN THE OFF POSITION.

## PANEL: H4L (EXISTING)

Location: MECH 301  
Supply From:  
Mounting: SURFACE  
Enclosure: NEMA 1

Volts: 480/277 Wye  
Phases: 3  
Wires: 4  
Sections: 1